

Name Harold Nufer

Service No. 158

Address 59 Bridge Street

Lot #59

Location

Kind of Pipe

Size

Size of Main

Repair—Renewal—New Service

Lexington Sewerage

A 494

Locations

Can 5-8-67


Date	Material	Amount	Total	Date	Amount	
Jul '66	26' 6" Transite pipe @5.00		130.00	12-1-66	<i>Deposit</i>	130.00
12/9/66	47' 6" Transite			7 - 66		
					26' 6" Transite	

DATE _____

TOWN OF LEXINGTON — BOARD OF PUBLIC WORKS

SEWER DIVISION

Sketch of Service Here **59**

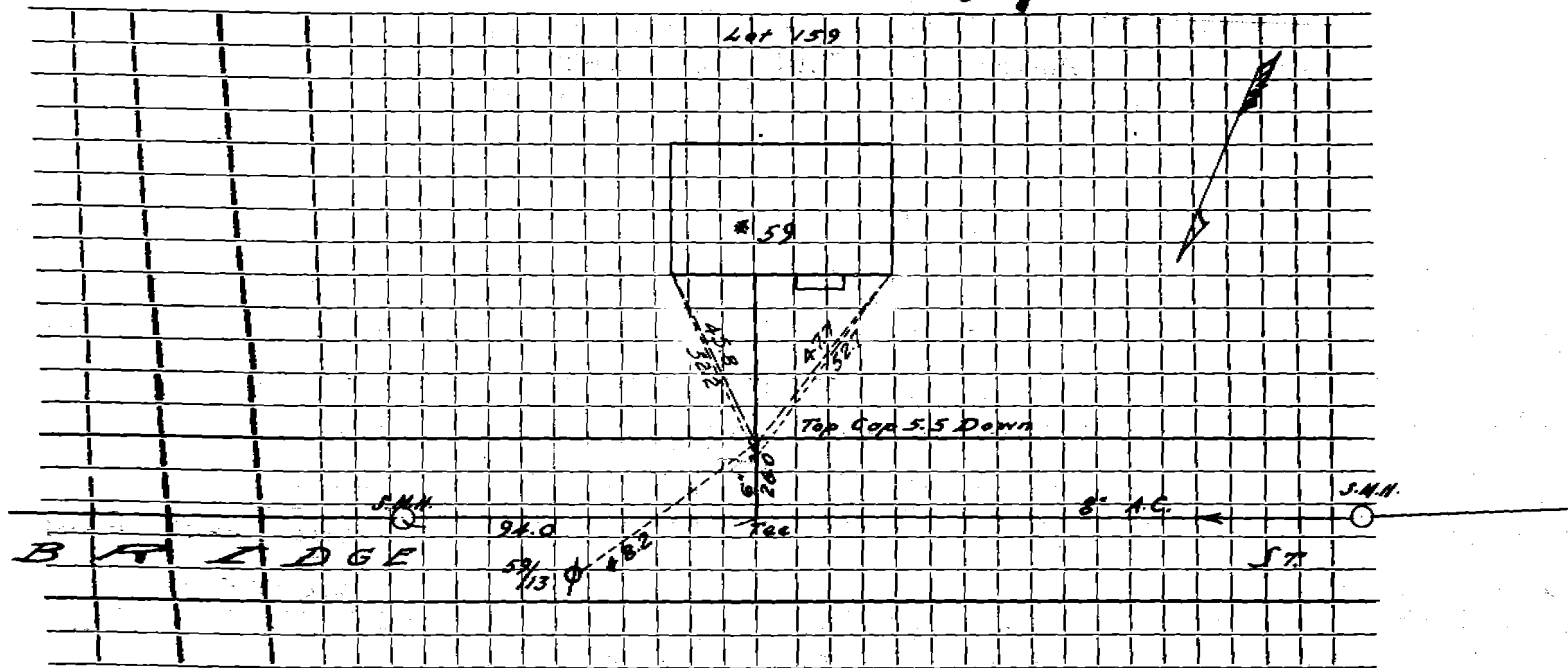

Connection made in Street. Work completed

Remarks:

.....

.....