

Name Mr. and Mrs. John L. Ennis

Service No. 151 ¹⁵¹

Address 62 Bridge Street

Location

Kind of Pipe

Size

Size of Main

Repair—Renewal—New Service Ferrari Plumbing and Heating # A 488

Location *Comm 5-8-67*


| Date | Material | Amount | Total | Date | Amount |
|------------------------|-----------------------------------|--------|--------|----------|----------------|
| Jul 166 261 | 6" Transite pipe @5.00 | | 130.00 | 11-23-66 | <i>Deposit</i> |
| 11/23/66 | 52'4" Cast Iron | | | 7- -66 | 26'6" Transite |
| | | | | | |
| | | | | | |
DATE _____

TOWN OF LEXINGTON — BOARD OF PUBLIC WORKS

SEWER DIVISION

Sketch of Service Here **62**

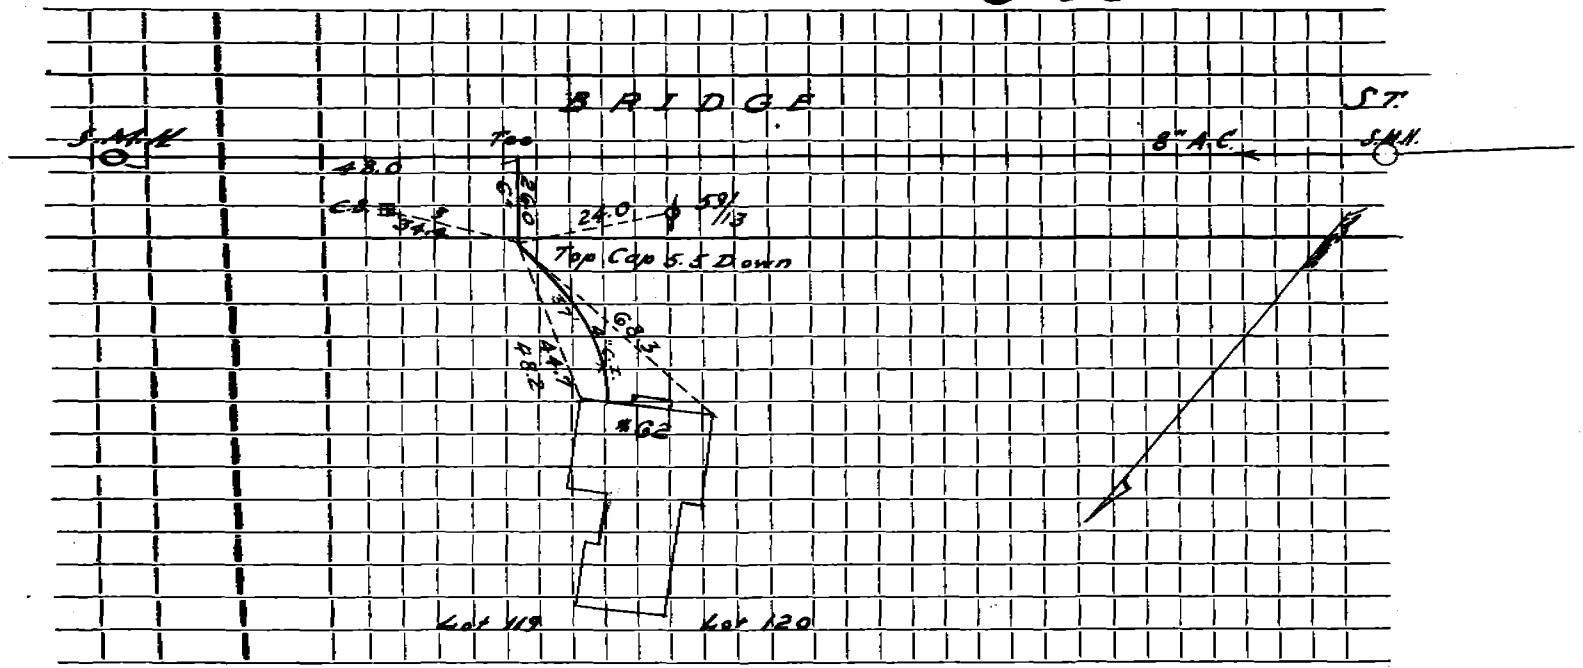

Section made in Street. Work completed

Remarks:

.....

.....

