




DATE \_\_\_\_\_

**TOWN OF LEXINGTON — BOARD OF PUBLIC WORKS**  
**SEWER DIVISION**

Sketch of Service Here **63**

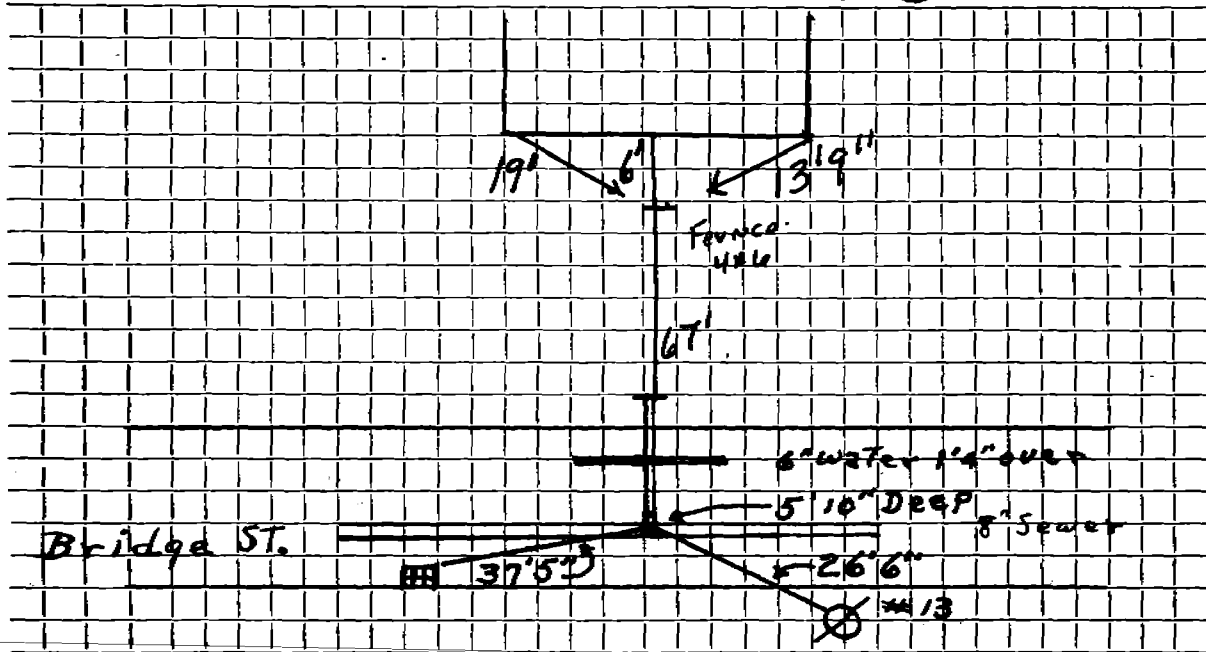

Connection made in 63 Bridge Street. Work completed .....

Remarks: .....

.....

.....