


DATE APRIL 1986

TOWN OF LEXINGTON — BOARD OF PUBLIC WORKS
SEWER DIVISION

Sketch of Service Here

66

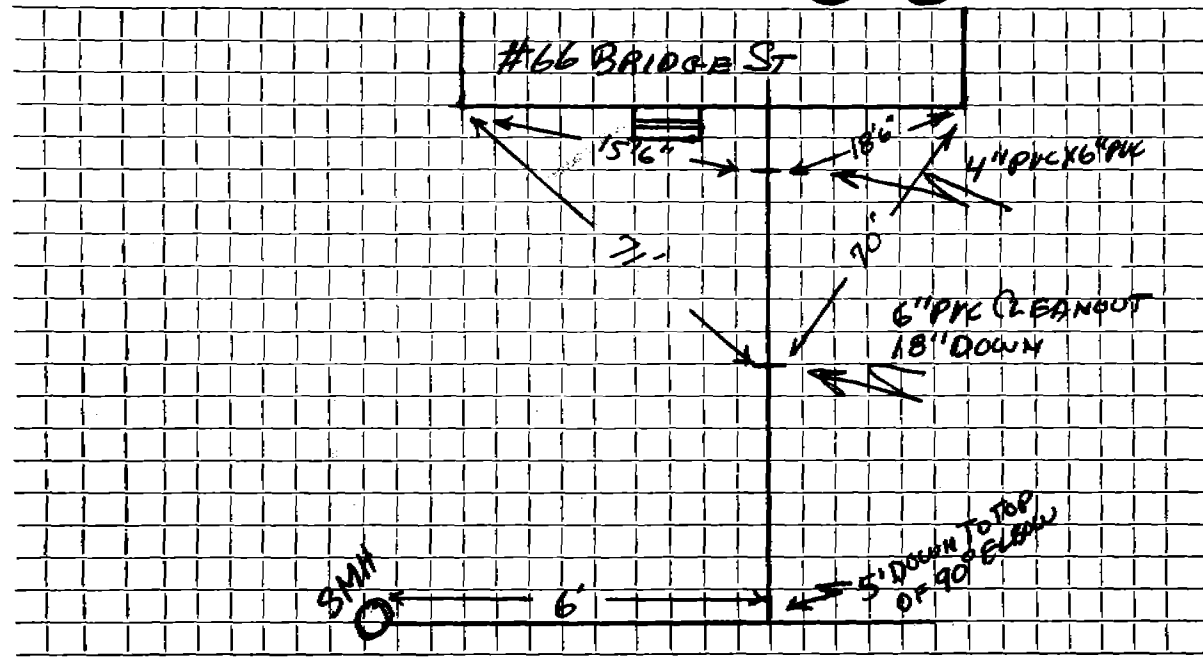

Connection made in BRIDGE ST..... Street. Work completed APRIL 18, 1986.....

Remarks:

.....

.....