

Name

Service No.

Address 69 Bridge Street

Lot 163

Location

Kind of Pipe

Size

Size of Main

Repair—Renewal—New Service

Location

Date

Material

Amount

Total

Date

Amount

~~Jul '66 13' 6" Transite pipe @5.00~~

~~65.00~~

7 - - 66

13' 6" Transite


DATE \_\_\_\_\_

# TOWN OF LEXINGTON — BOARD OF PUBLIC WORKS

## SEWER DIVISION

Sketch of Service Here

# 69

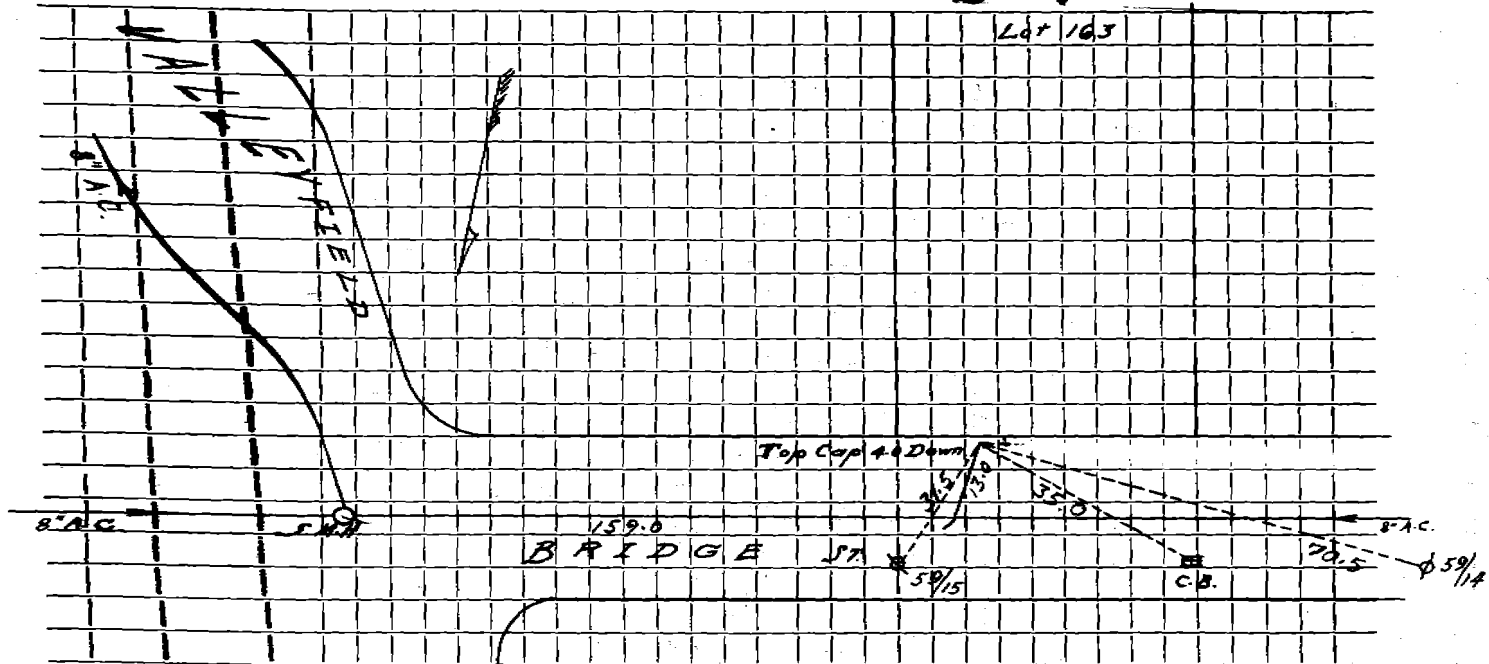

Connection made in ..... Street. Work completed .....

Remarks: .....

.....

.....