

Name Richard Hamilton

Service No. 170

Address 72 Bridge Street

Location

Kind of Pipe

Size

Size of Main

Repair—Renewal—New Service ✓ Valeri Const, # 2377

Location FEB 10 1975


Date	Material	Amount	Total	Date	Amount
Jul 166	26'	6" Transite pipe @5.00	130.00	11-13-73	130.00
11-23	73	45' - 6" ACP		7- - 66	
		10' - 4" CI		26'	6" Transite

DATE _____

TOWN OF LEXINGTON — BOARD OF PUBLIC WORKS

SEWER DIVISION

Sketch of Service Here **72**

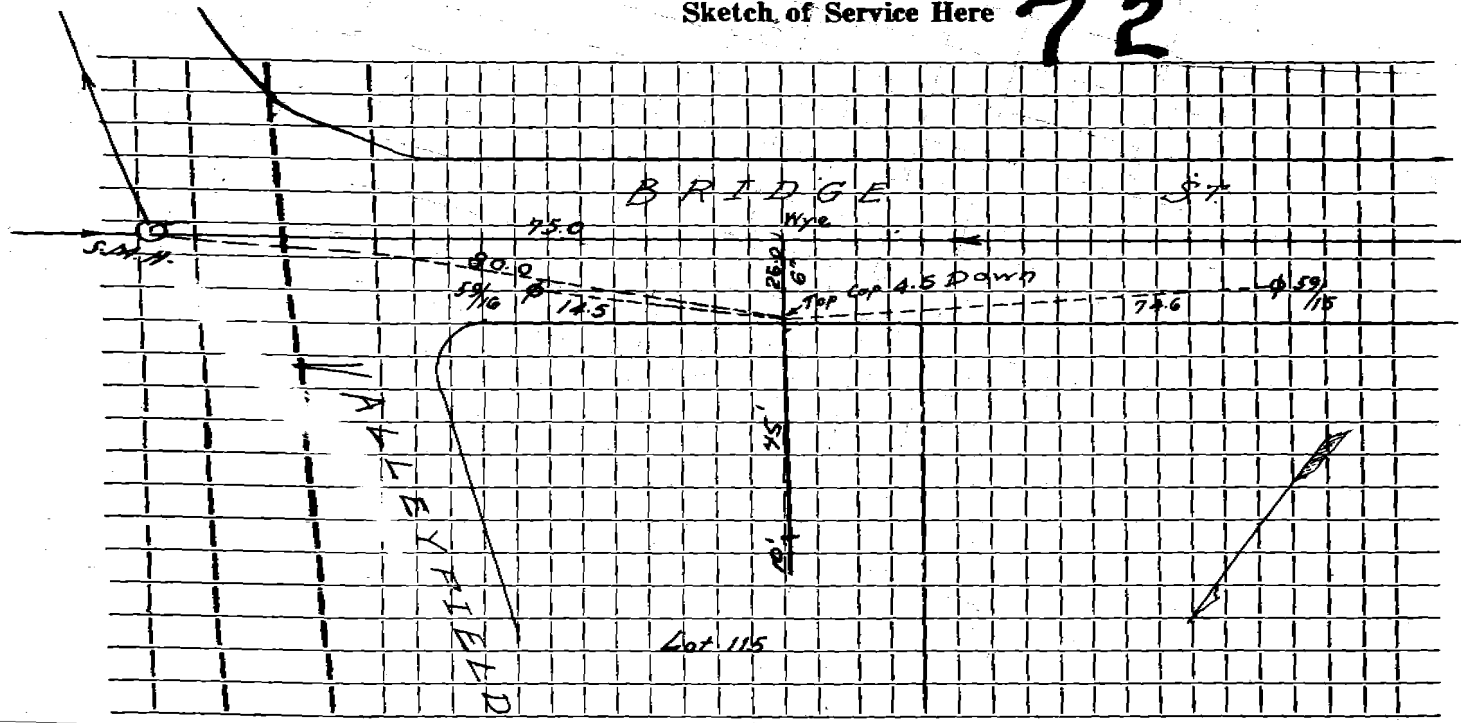

Connection made in Street. Work completed

Remarks: