

Name

Service No.

Address 83 Bridge Street

Lot 102

Location

Kind of Pipe

Size

Size of Main

Repair—Renewal—New Service

Location

Date	Material	Amount	Total	Date	Amount
<del>Jul '66</del> 21	<del>6" Transite pipe @5.00</del>		105.00		
				7- - 66	6" Transite


DATE \_\_\_\_\_

# TOWN OF LEXINGTON — BOARD OF PUBLIC WORKS

## SEWER DIVISION

Sketch of Service Here

# 83

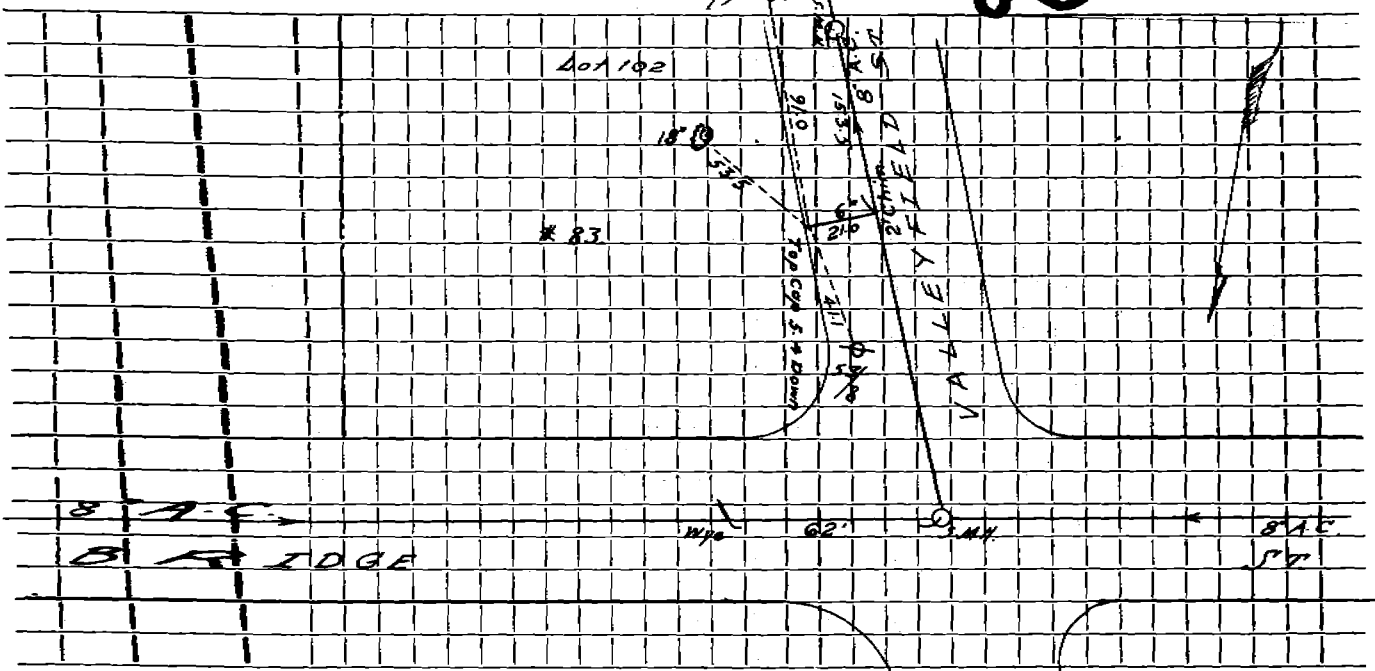

Connection made in ..... Street. Work completed .....

Remarks: .....