

Name Stratvern Realty Inc.

Service No. 89

Address 84 Bridge Street

Location

Kind of Pipe

Size of Main

Repair—Renewal—New Service Kirkland #718

Location MAR 18 1968

Date		Material	Amount	Total	Date		Amount
Jul '66	25'	6" Transite pipe @	5.00	125.00	7-27-67		125.00
8-16-67	30'	6" Transite pipe					
	10'	4" Cast Iron pipe			7-	-66	
					25'	6" Transite	


DATE _____

TOWN OF LEXINGTON — BOARD OF PUBLIC WORKS

SEWER DIVISION

Sketch of Service Here

84

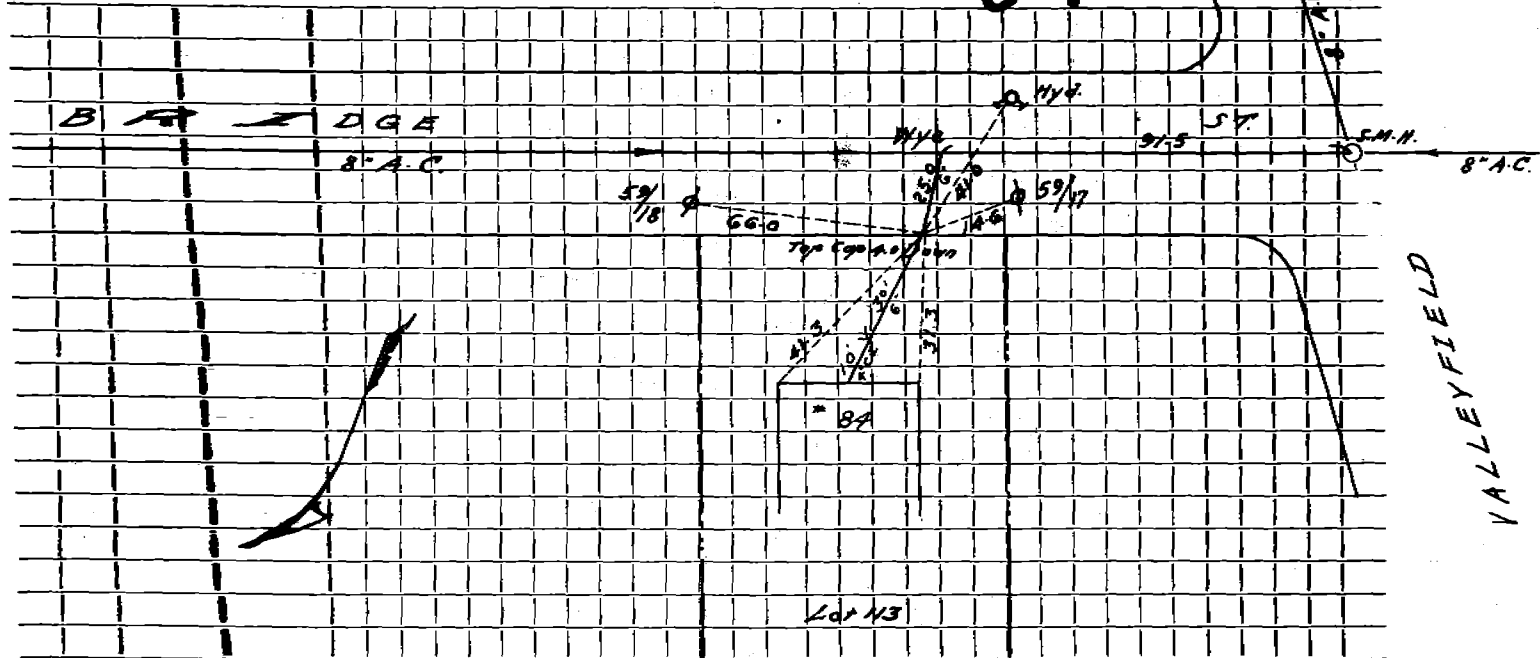

Connection made in Street. Work completed

Remarks:
.....
.....