

Name

Service No.

Address 89 Bridge Street

Location

Kind of Pipe

Size

Size of Main

Repair—Renewal—New Service

Location


Date	Material	Amount	Total	Date	Amount
<del>Jul '66</del>	<del>25' 6" Transite pipe @5.00</del>		125.00		
				7- -66	
					25' 6" Transite

DATE \_\_\_\_\_

**TOWN OF LEXINGTON — BOARD OF PUBLIC WORKS**  
**SEWER DIVISION**

Sketch of Service Here

**89**

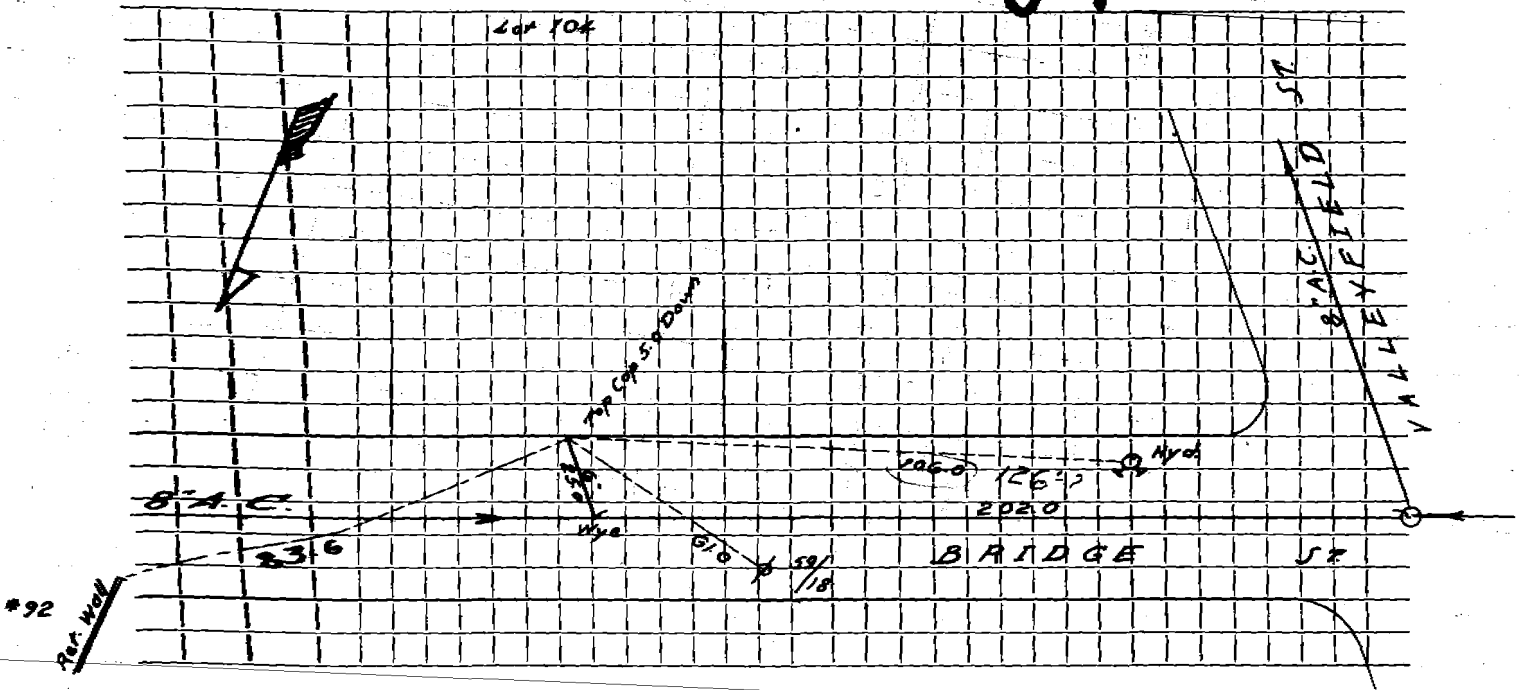

Connection made in ..... Street. Work completed .....

Remarks: .....  
.....  
.....