

Name Roger F. Borghesani

Service No. 97

Address 9 Bridge Street

Location

Kind of Pipe

Size

Size of Main

Repair—Renewal—New Service

Craftsmen #1206

Location

JAN 27 1969

Date	Material	Amount	Total	Date	Amount	
1965	19' Transite pipe @ 7.00		\$133 00	10-10-68	Deposit	133.00
10-16-68	40' 6" Transite pipe					
	5' 4" Cast Iron pipe					


DATE _____

TOWN OF LEXINGTON — BOARD OF PUBLIC WORKS

SEWER DIVISION

Sketch of Service Here

9

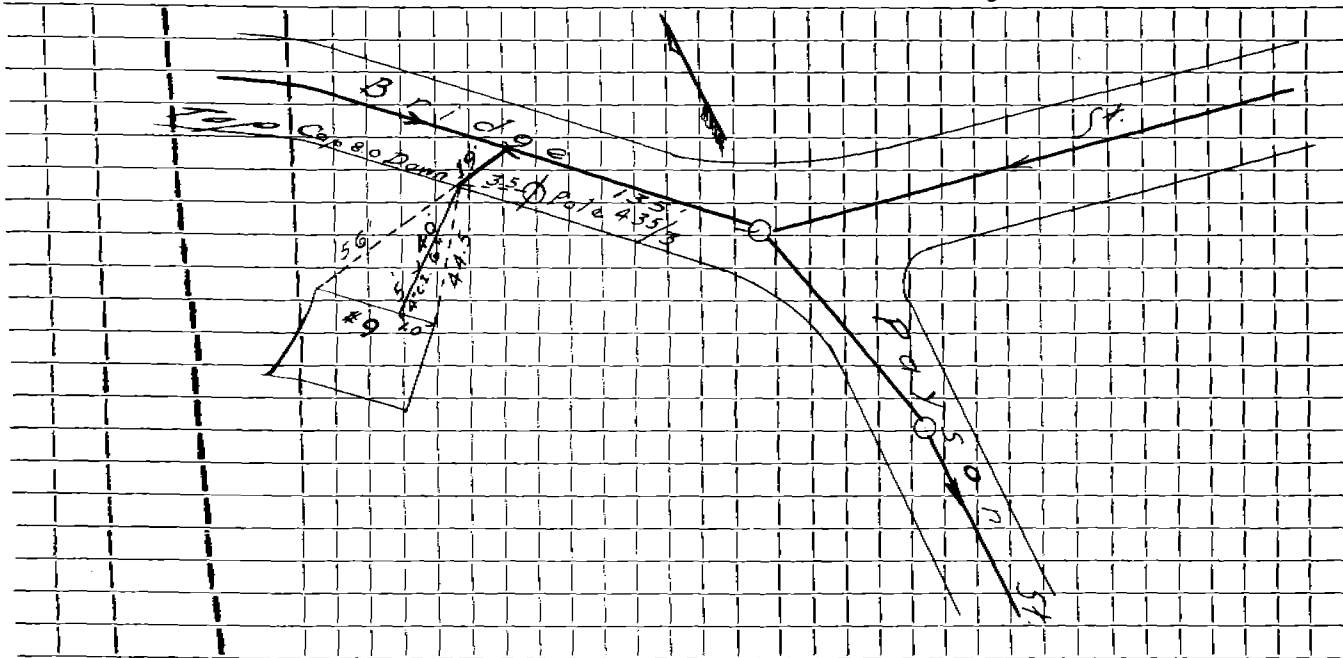

Connection made in Street. Work completed

Remarks:

.....

.....

.....