

Name Stratvern Realty

Service No. 123

Address 91 Bridge Street

Location

Kind of Pipe

Size

Size of Main

Repair—Renewal—New Service Kirkland #812

Location

MAR 18 1968


Date	Material	Amount	Total	Date	Amount
Jul '66 25'	6" Transite pipe @ 5.00		125.00		
10-19-67 27'	6" Transite pipe				
10'	4" Cast Iron pipe			7- - 66	
				25' 6" Transite	

DATE _____

TOWN OF LEXINGTON — BOARD OF PUBLIC WORKS

SEWER DIVISION

Sketch of Service Here **91**

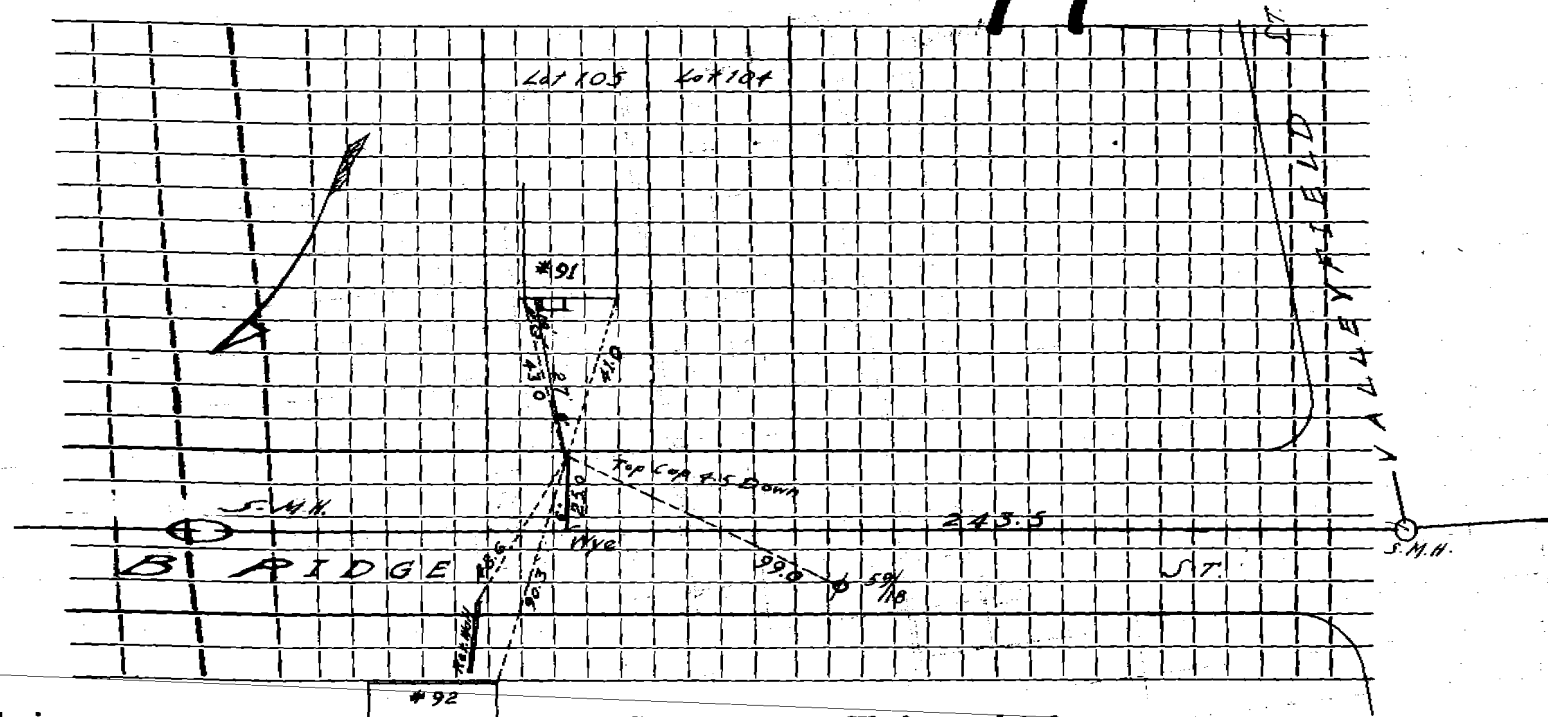

Connection made in Street. Work completed

Remarks:
.....
.....