




DATE \_\_\_\_\_

# TOWN OF LEXINGTON — BOARD OF PUBLIC WORKS

## SEWER DIVISION

Sketch of Service Here **92**

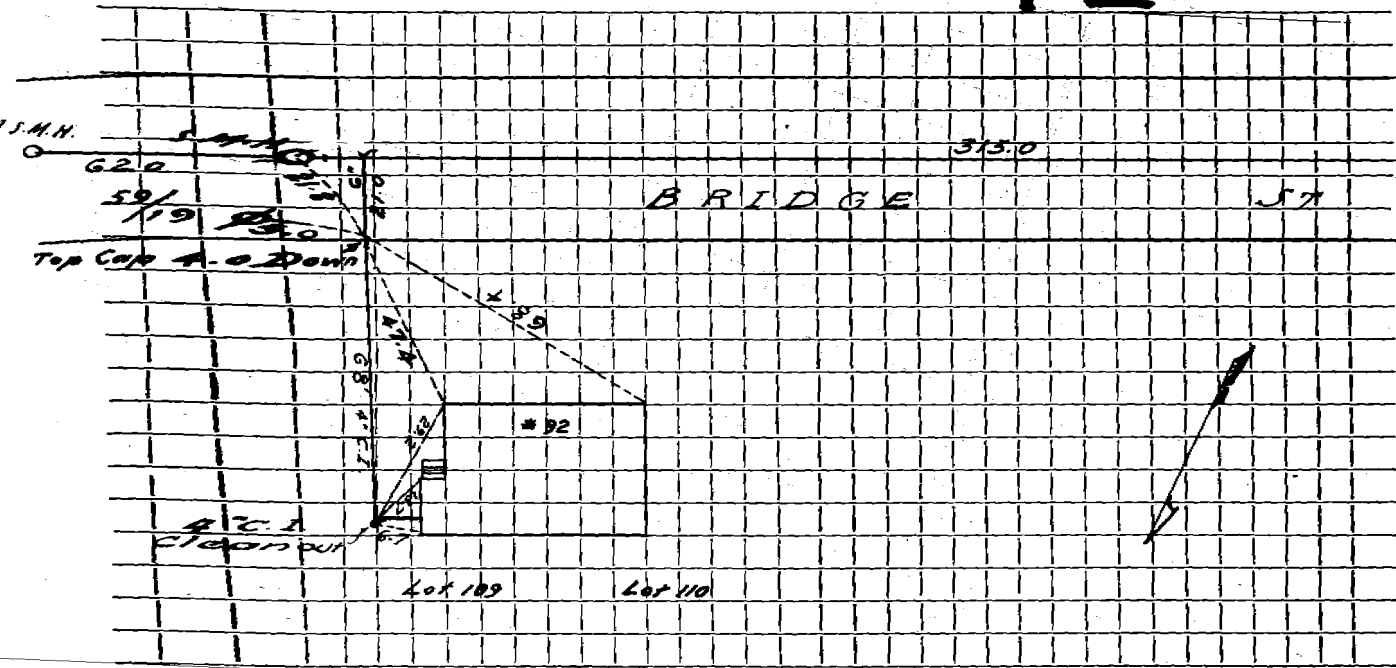

VALLEY FIELD ST  
S.M.H.

Connection made in ..... Street. Work completed .....

Remarks: .....