

Name Lauri A. Lindell

Service No. 136³⁶

Address 95 Bridge Street

Lot 107

Location

Kind of Pipe

Size

Size of Main

~~Repair~~—~~Renewal~~—New Service Craftsmen, Inc.

A 456


Location *Conn 5-867*

Date		Material	Amount	Total	Date		Amount
Jul '66	26	6" Transite pipe @ 5.00	130.00	130.00	10-27-66	<i>Deposit</i>	130.00
10/28/66		30'6" Transite					

DATE _____

TOWN OF LEXINGTON — BOARD OF PUBLIC WORKS
SEWER DIVISION

Sketch of Service Here **95**

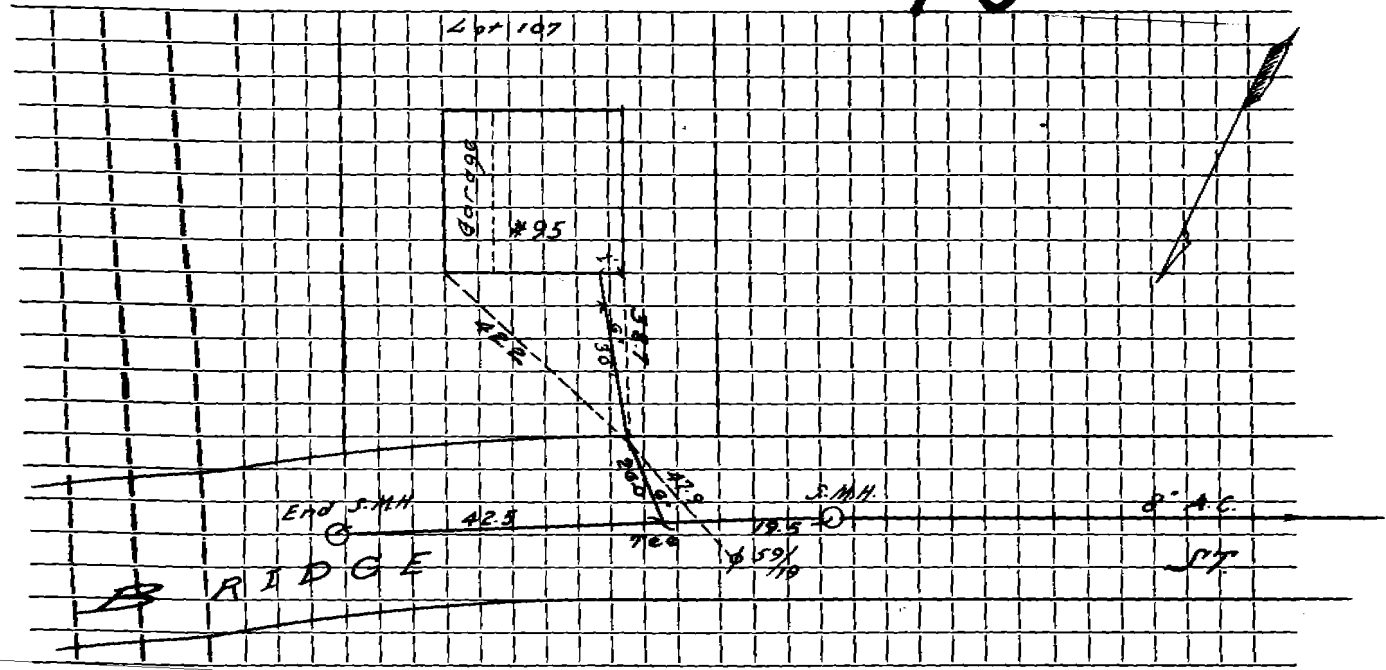

Connection made in Street. Work completed

Remarks:
.....
.....