

Name

Service No.

Address 40 BRIDGE ST

Location LEXINGTON, MA

Kind of Pipe SDR35 PVC

Size 6"

Size of Main

Repair ~~Renewal~~ New Service


Location

Date	Material	Amount	Total	Date	Amount
7/14/22	6" Clewmat	1			
	4" to 6" Fernco	1			
	6" SDR35 PVC				
	22.5° Bend	1			
	6" Tee				

DATE 7/14/22

TOWN OF LEXINGTON — BOARD OF PUBLIC WORKS  
SEWER DIVISION

Sketch of Service Here

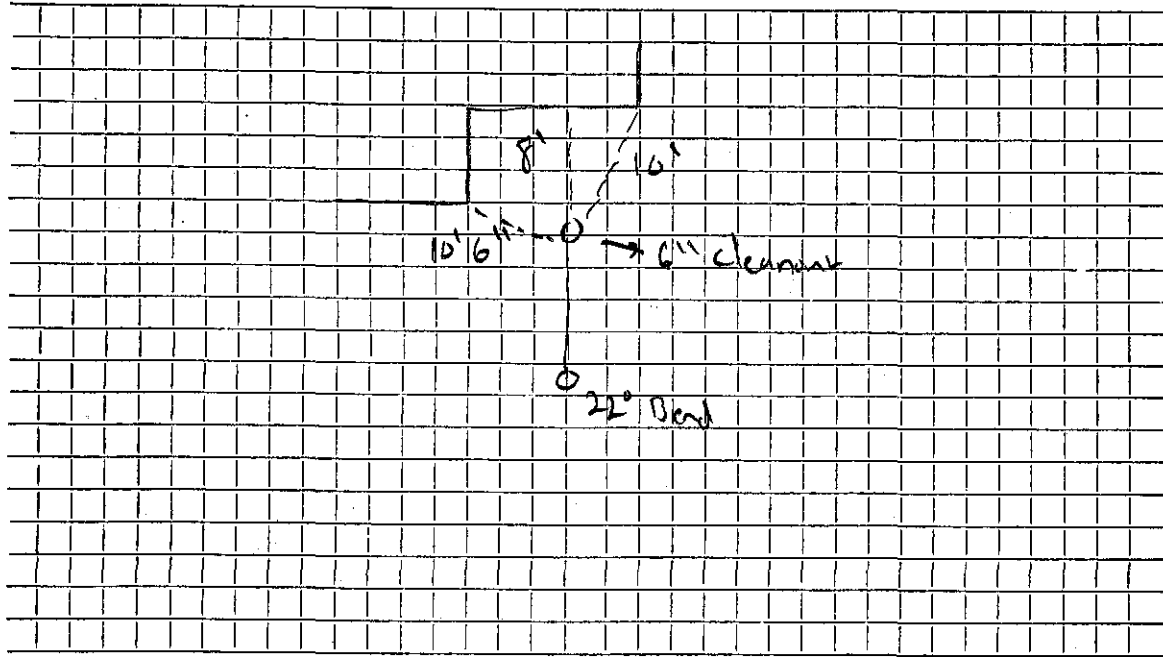

Connection made in ..... Street. Work completed .....

Remarks: INSTALLED BY TOWN EXCAVATING .....