

Name Anna L. White

Service No. 98

Address 10 BRIGGS ROAD

Location

Kind of Pipe AC

Size 6"

Size of Main 8"

~~REPLACEMENT~~ New Service Eagle #3207


Location DEC 26 1978

Date	Material	Amount	Total	Date	Amount	
8/10/78	5' 6" AC	\$14	\$70	11-17-78	Deposit	71.00
11/24/78	40' 6" Transite Pipe			8-18-78	5' 6" A.C. Pipe	
	6' 4" Cast Iron Pipe					

DATE _____

TOWN OF LEXINGTON — BOARD OF PUBLIC WORKS
SEWER DIVISION

Sketch of Service Here **10**

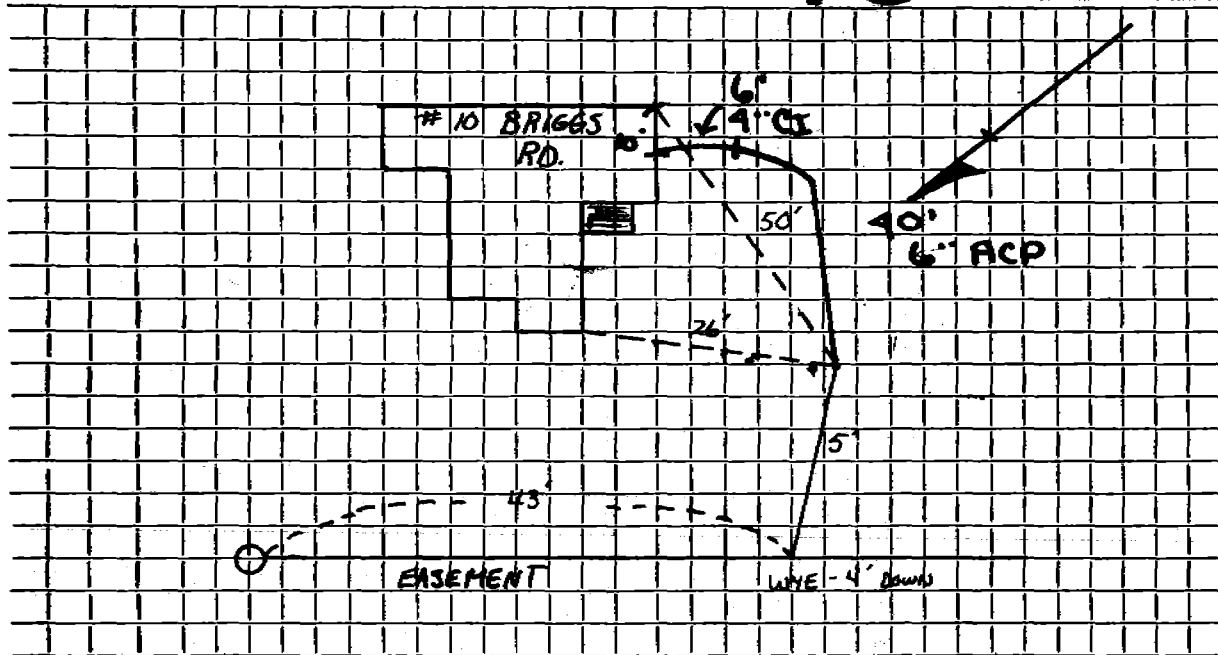

Connection made in Street. Work completed

Remarks:

.....
.....