


DATE _____

TOWN OF LEXINGTON — BOARD OF PUBLIC WORKS SEWER DIVISION

Sketch of Service Here **11**

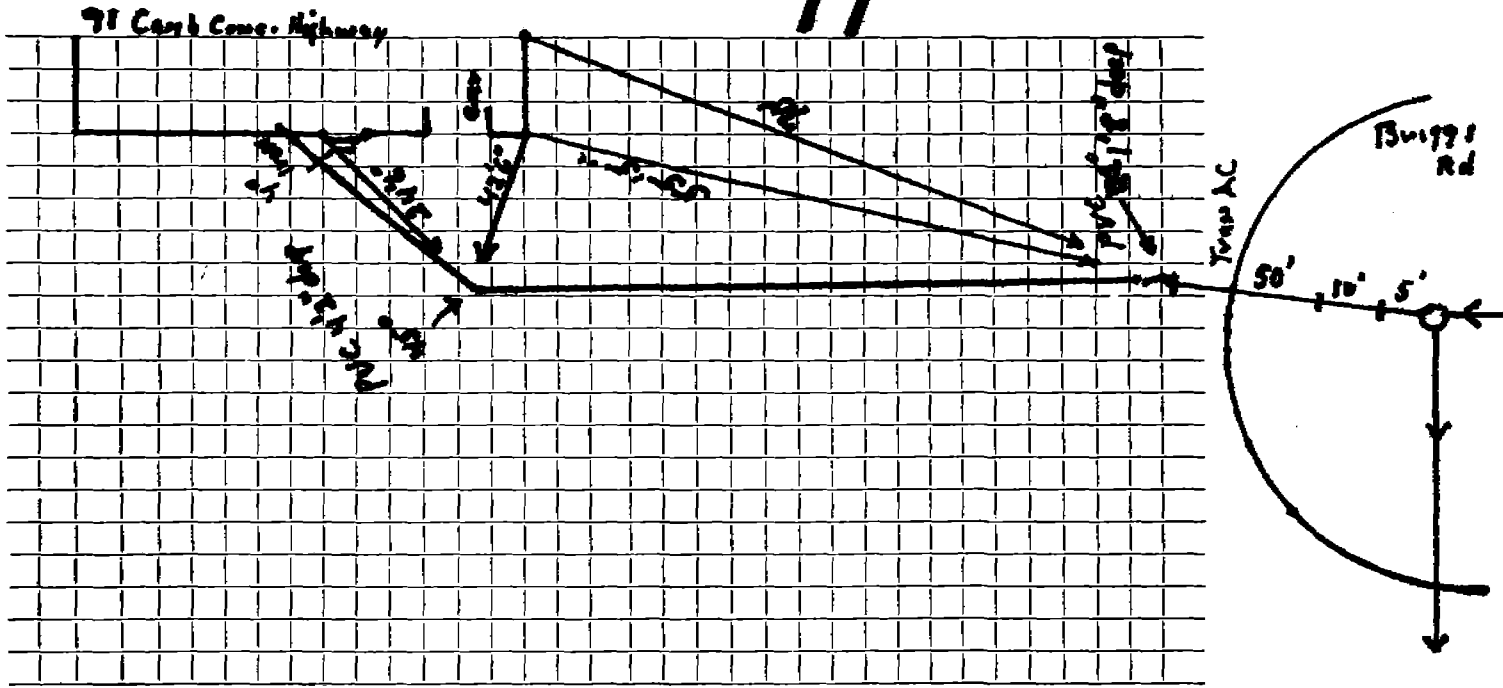

Connection made in Street. Work completed

Remarks: *AC Pipe outside... 4" P.V.C. inside.*

.....
.....