


DATE _____

TOWN OF LEXINGTON — BOARD OF PUBLIC WORKS
SEWER DIVISION

Sketch of Service Here

3

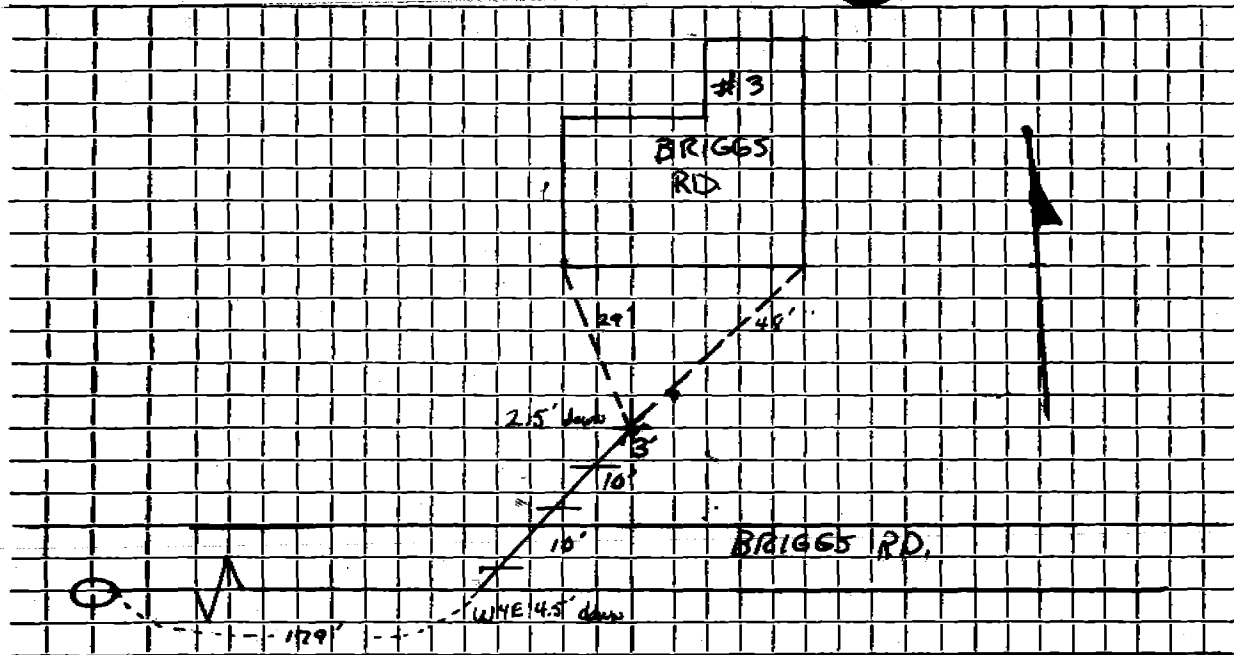


Connection made in Street. Work completed

Remarks:
.....
.....

DATE MAY 28 1998

TOWN OF LEXINGTON — BOARD OF PUBLIC WORKS
SEWER DIVISION

Sketch of Service Here

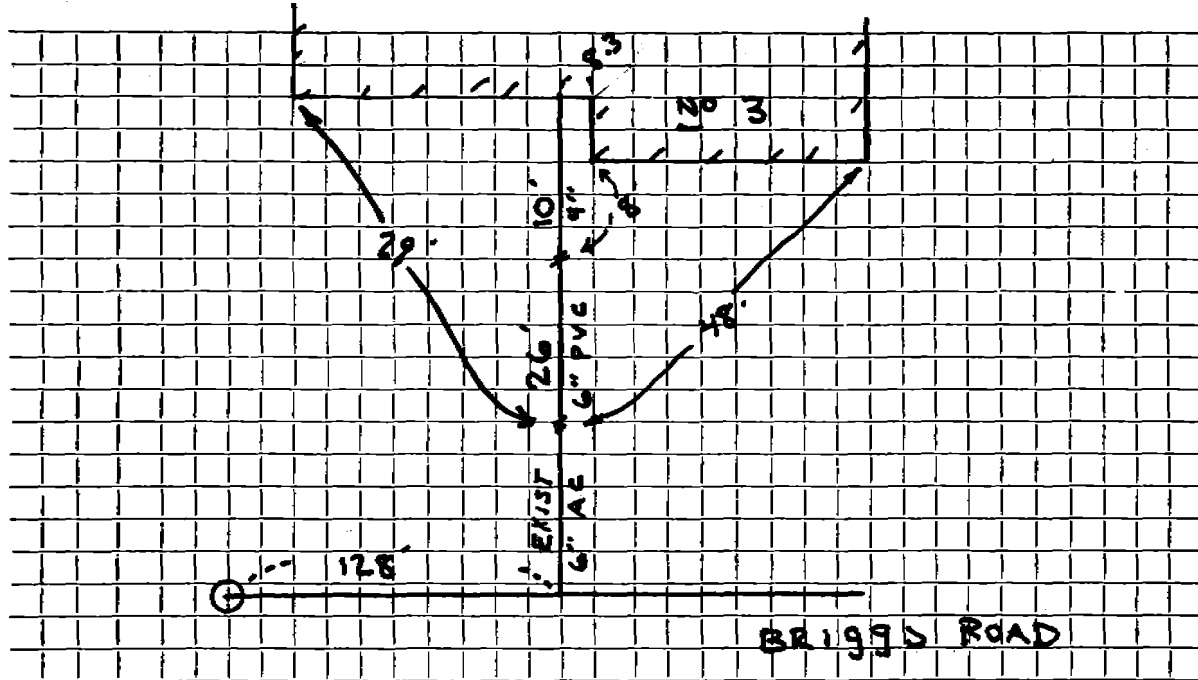

Connection made in BRIGGS ROAD Street. Work completed ARLEX OIL

Remarks:

.....
.....
..... FIELD BOOK 98-1 TOM