

Name

Service No.

Address # 9 BRIGGS RD.

Location

Kind of Pipe AC

Size 6"

Size of Main 8"

Repair—Renewal—New Service ✓

Daniels Equip. Corp. #3398

Location


Date	Material	Amount	Total	Date	Amount
8/10/70	30' 6" AC	*14	*96.		
6/29/79	40' 6" Transite Pipe		NO PREVIOUS CHARGE		
	10' 4" Cast Iron Pipe				
				11/2/78 PER W.J. MARTIN	
				(N. Chg.)	
				8-18-78	
				30' 6" A.C. Pipe	

DATE _____

TOWN OF LEXINGTON — BOARD OF PUBLIC WORKS
SEWER DIVISION

Sketch of Service Here

9

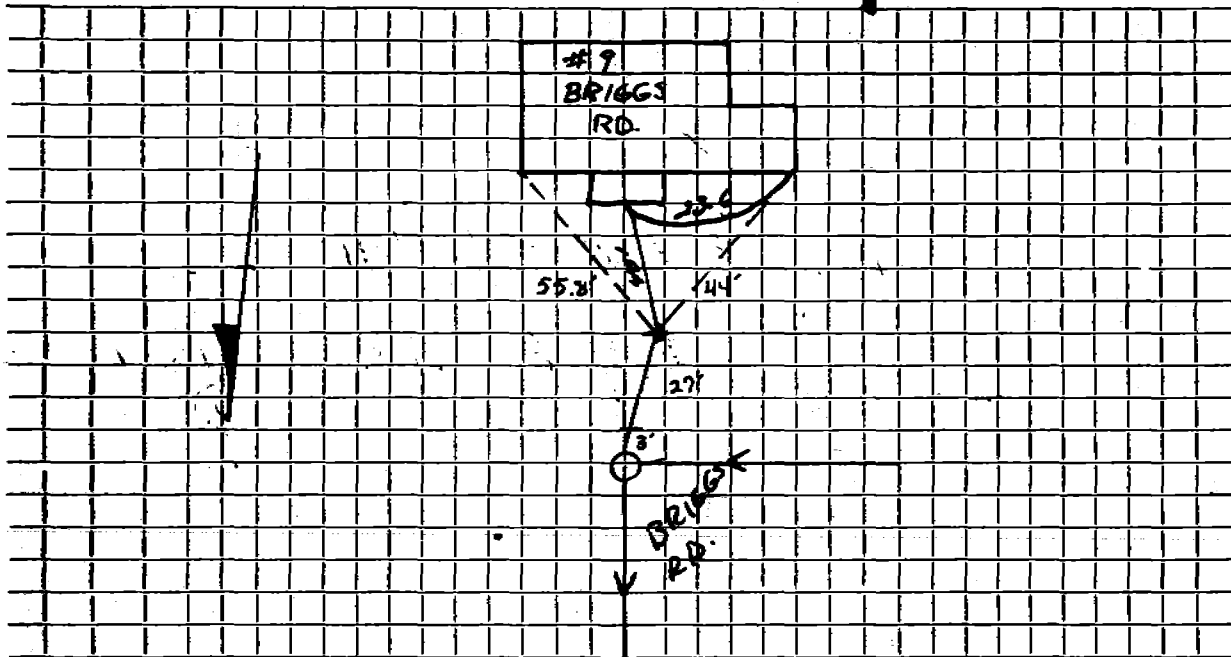

Connection made in Street. Work completed

Remarks:

.....
.....