

Name Moore Realty Trust

Service No.

Address 11 Brigham Road

Lot #6

Location

Kind of Pipe

Size

Size of Main

~~Repair~~ New Service

DeFlice #966
J.M. Lucente

Location

Date

Material

Amount

Total

Date

Amount

~~4-14-65 63' 6" Transite pipe~~

3-26-68 40' 6" Transite pipe

10' 4" Cast Iron pipe

4-14-65


63' 6" Transite

DATE _____

TOWN OF LEXINGTON — BOARD OF PUBLIC WORKS

SEWER DIVISION

Sketch of Service Here

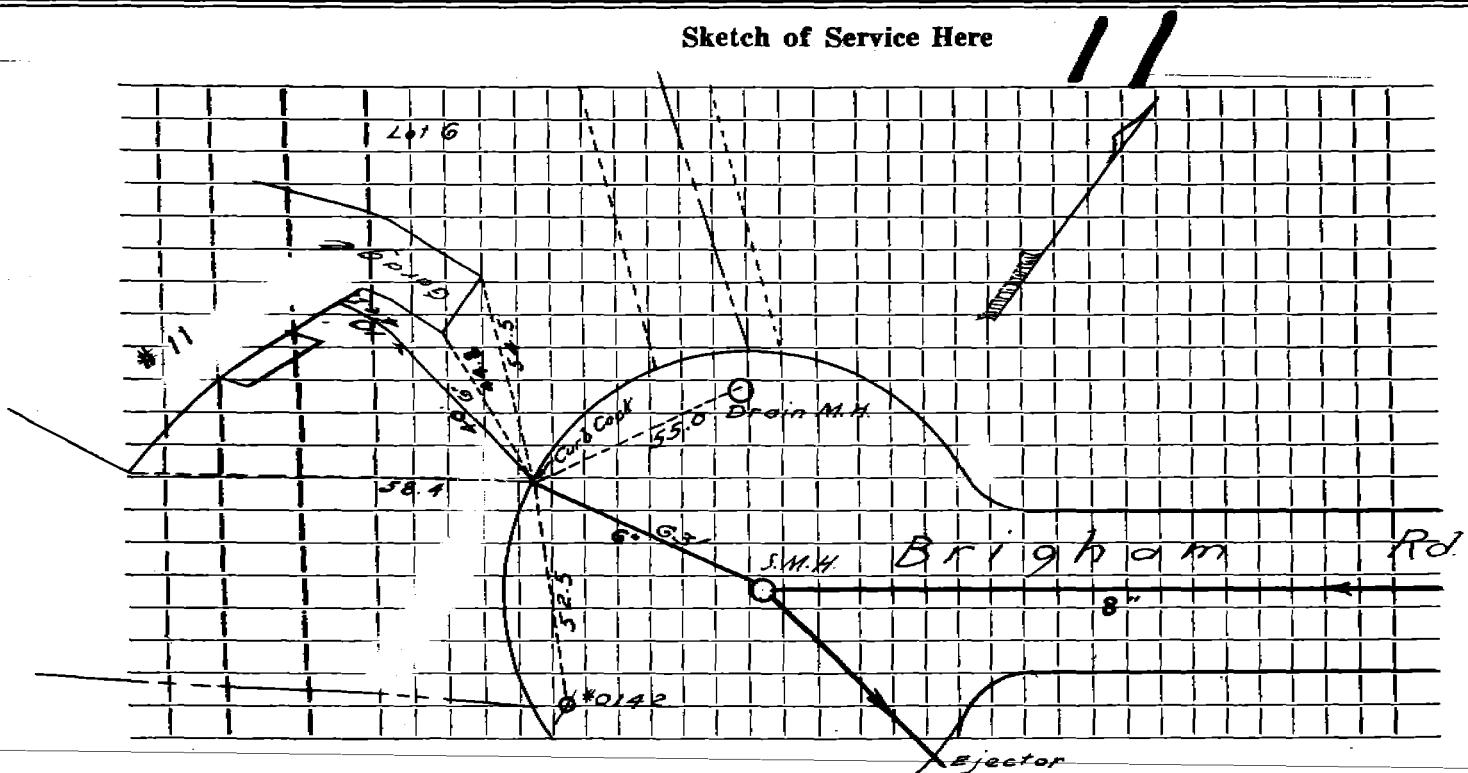

Connection made in Street. Work completed

Remarks: