

Leonard Millen  
 Name ~~Moore Realty Trust~~

Service No.

Address 8 Brigham Road

Lot #8

Location

Kind of Pipe Permit #246

Size

Size of Main

~~Repair Renewal~~ New Service

J.M. Lucente #2236

Location

Date	Material	Amount	Total	Date	Amount
<del>4-14-65</del>	<del>39' 6" Transite pipe</del>				
				4-14-65	
				39' 6" TRANS ; Te	

H.S.M. 18501


DATE \_\_\_\_\_

# TOWN OF LEXINGTON — BOARD OF PUBLIC WORKS

## SEWER DIVISION

Sketch of Service Here

8

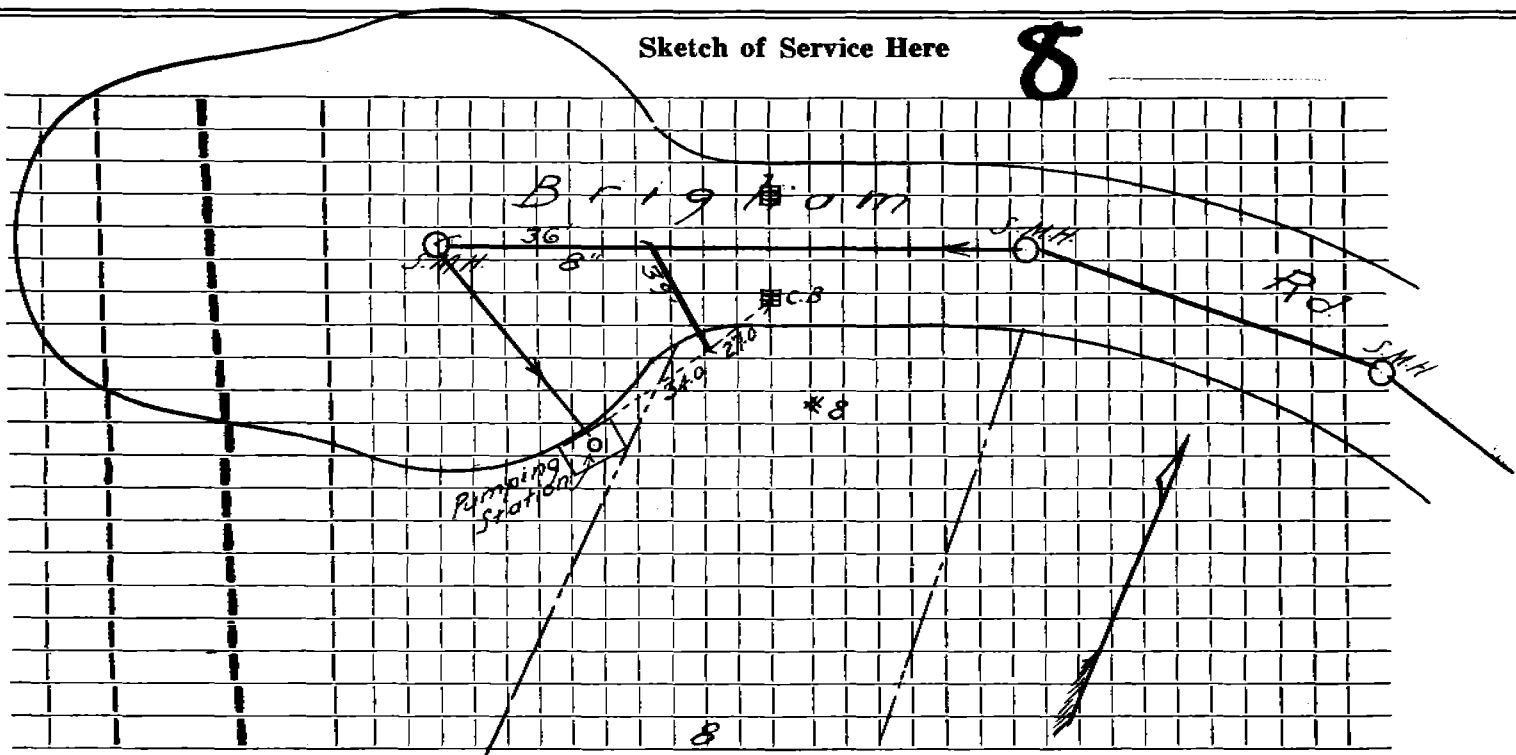

Connection made in ..... Street. Work completed .....

Remarks: .....  
.....  
.....