

Name

Service No.

Address 16 Brookside Avenue Lot 138-139 - 92

Location

Kind of Pipe 6" PVC

Size

Size of Main 24" A.C.

Repair—Renewal New Service P. Rose - Septic Abandon

Location Lot 92


Date	Material	Amount	Total	Date	Amount
<del>1965</del>	<del>31' Transite pipe @ 7.00</del>		\$217 00		
10/15/07	20' 4" Cast Iron - Existing				
	64' 6" PVC			1965	
	1 4x6 FENCE			EXIST - 31'	6" Transite
	1 6" ACX PVC FENCE				
	R.S. 457				

DATE \_\_\_\_\_

TOWN OF LEXINGTON — BOARD OF PUBLIC WORKS  
SEWER DIVISION

Sketch of Service Here

16

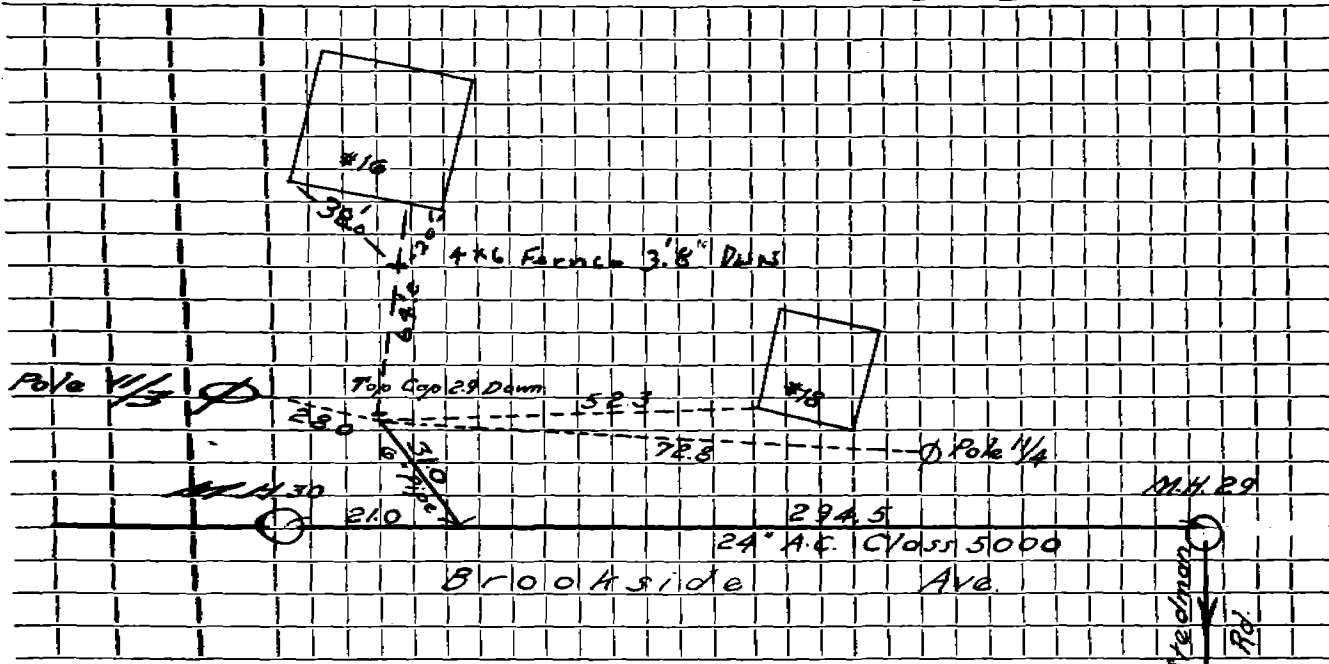

Connection made in \_\_\_\_\_ Street. Work completed 10/15/07 P. Rose

marks: I.N.Z.T. M.F.