

Name

Service No.

Address 18 BROOKSIDE AVE

Location

Kind of Pipe PVC + EXST. A.C.

Size 6"

Size of Main

Repair—Renewal—New Service

J McLaughlin

Location

Date	Material	Amount	Total	Date	Amount
------	----------	--------	-------	------	--------


10/28/03	71.6	6" PVC			
	4.0	4" Sch 40 PVC			
	1	4x6 Fernco			
	1	22° bend 6" PVC			
	1	1.6" - 6" Nipple			
	1	6" ACX PVC Fernco			

EXIST 6" A.C. Pipe

DATE _____

TOWN OF LEXINGTON — BOARD OF PUBLIC WORKS
SEWER DIVISION

Sketch of Service Here
BROOKSIDE AVE

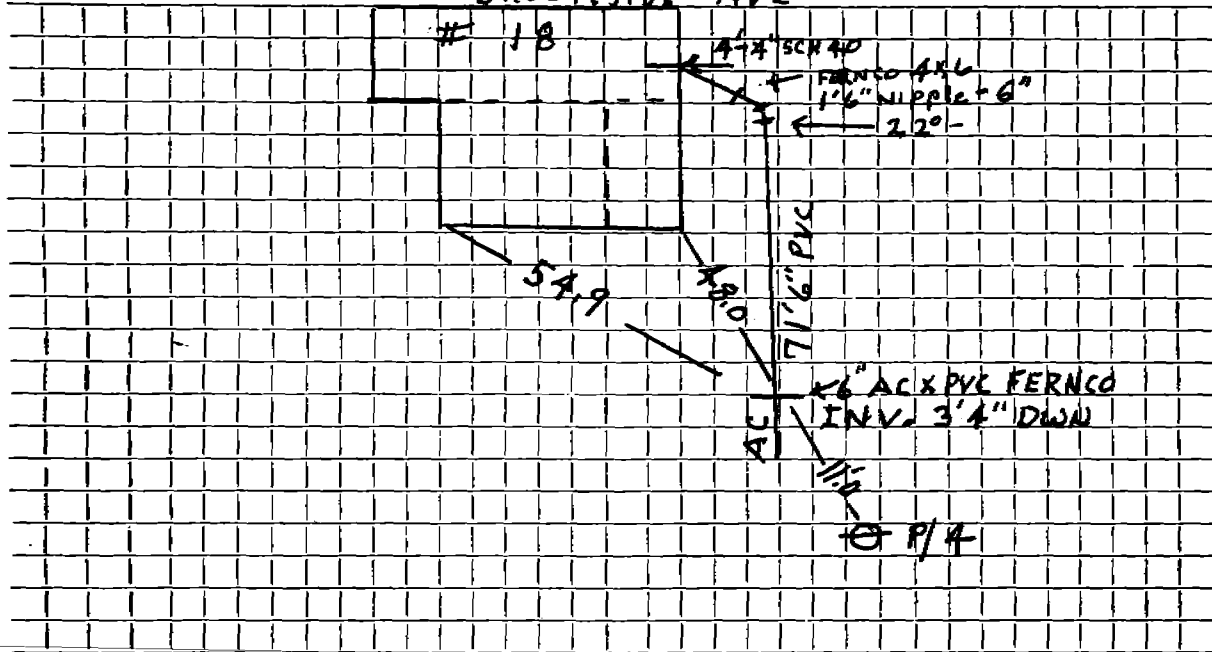

Connection made in Street. Work completed

Remarks:

Connection to main 228' up from
Stedman Rd