

Name

Service No.

Address 22 Brookside Avenue Lot 141

Location

Kind of Pipe

Size

Size of Main

Repair—Renewal—New Service

Location

Date

Material

Amount

Total

Date

Amount

~~1965~~ ~~31'~~ ~~Transite pipe @ 7.00~~ \$217 00

1965


31' 6" Transite

DATE \_\_\_\_\_

# TOWN OF LEXINGTON — BOARD OF PUBLIC WORKS

## SEWER DIVISION

Sketch of Service Here **22**

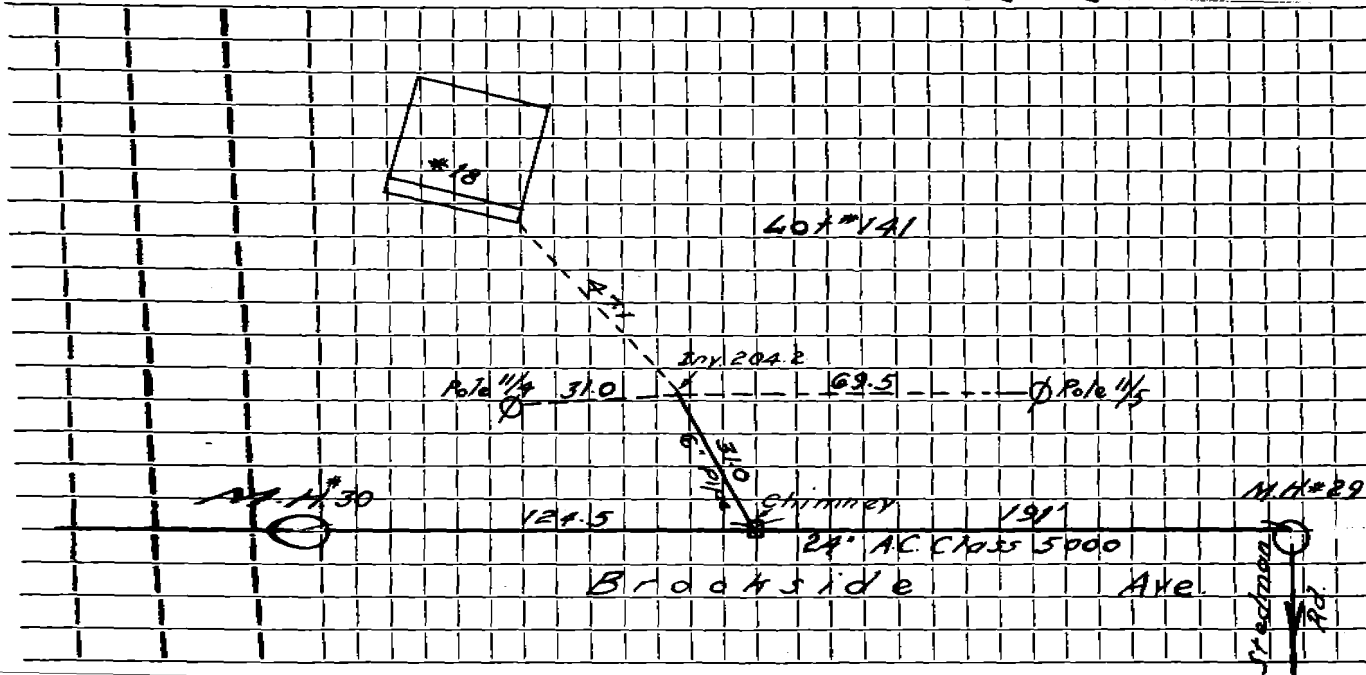

Section made in ..... Street. Work completed .....

Remarks: .....

.....  
.....