


DATE _____

TOWN OF LEXINGTON — BOARD OF PUBLIC WORKS
SEWER DIVISION

Sketch of Service Here

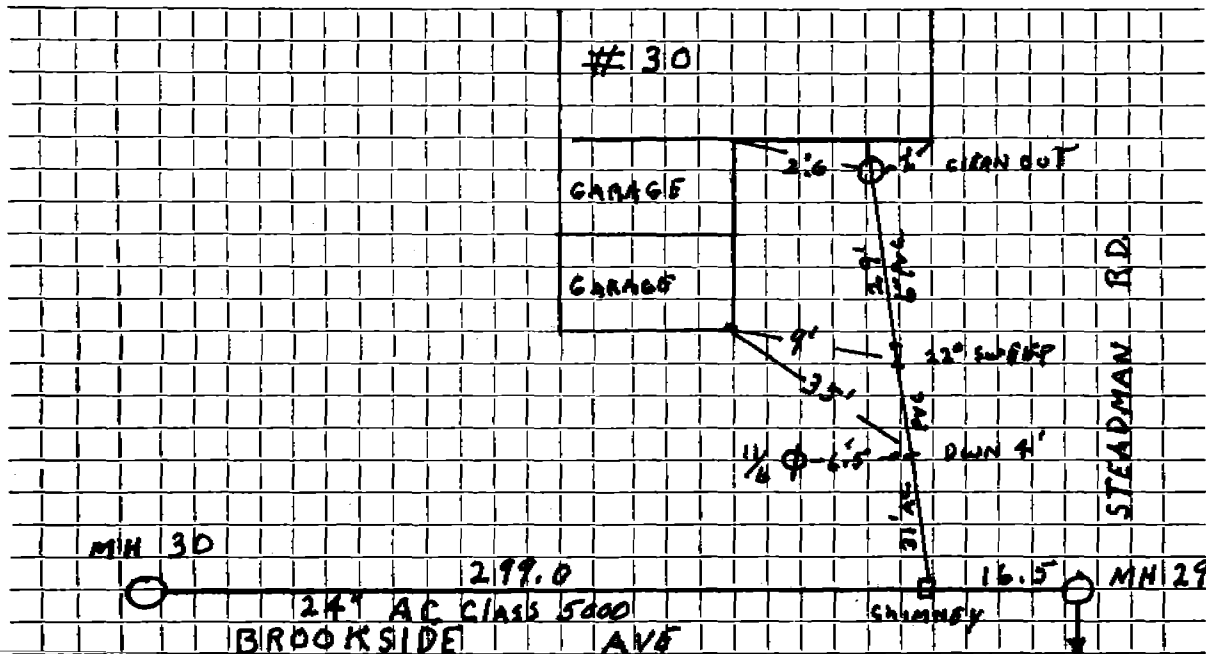

Connection made in BROOKSIDE Street. Work completed 3/24/00

Remarks: TEAR DOWN