

Name Oak Park Corp.

Service No.

Address ~~10 Middlebrook Road~~ 1 Brookwood Road

Location

Kind of Pipe

Size

Size of Main

Repair—Renewal—New Service Lucente #1961

Location


Date		Material	Amount		Total	Date	Amount	
11-24-71	35'	6" Transite pipe						
	10'	4" Cast Iron pipe						

H. B. N. 18501

DATE \_\_\_\_\_

**TOWN OF LEXINGTON — BOARD OF PUBLIC WORKS**  
**SEWER DIVISION**

Sketch of Service Here

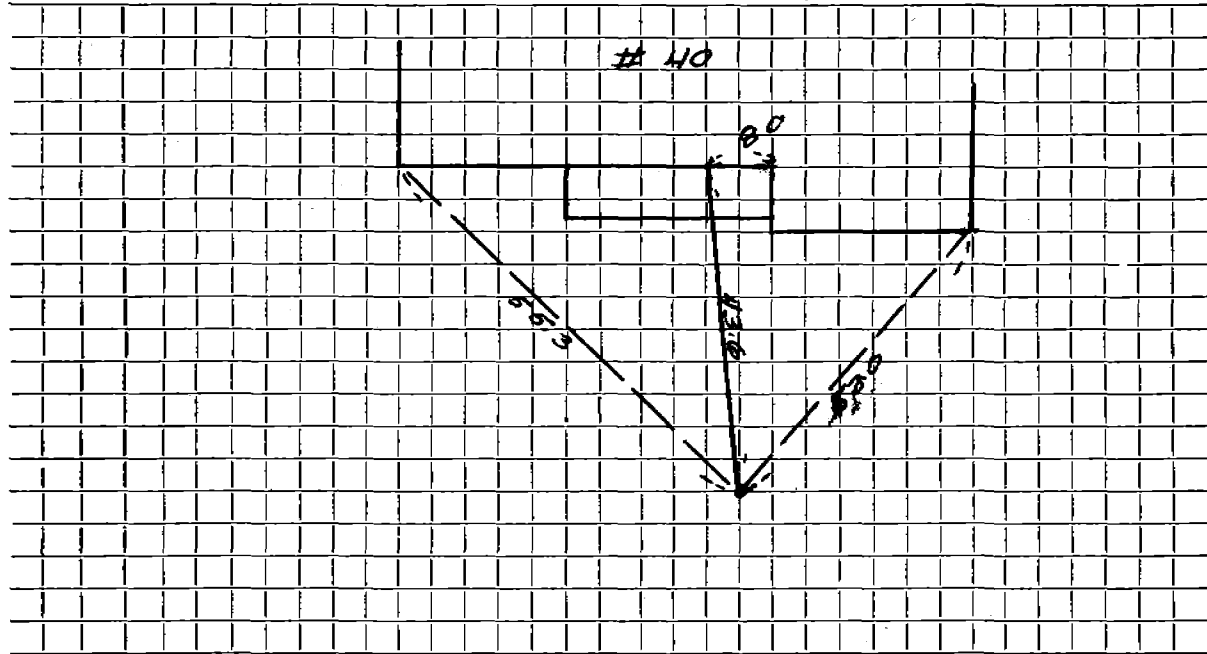

Connection made in ..... Street. Work completed .....

Remarks: .....  
.....  
.....