

Name Oak Park Corp.

Service No.

Address 11 Brookwood Rd.

Location

Kind of Pipe

Size

Size of Main

Repair—Renewal—New Service

Lucente #1586

Location

Date

Material

Amount

Total

Date

Amount

~~5-15-70 30' 6" Transite Pipe~~

5-15-70

30' 6" Transite


DATE _____

TOWN OF LEXINGTON — BOARD OF PUBLIC WORKS

SEWER DIVISION

11 Brookwood Road

Sketch of Service Here

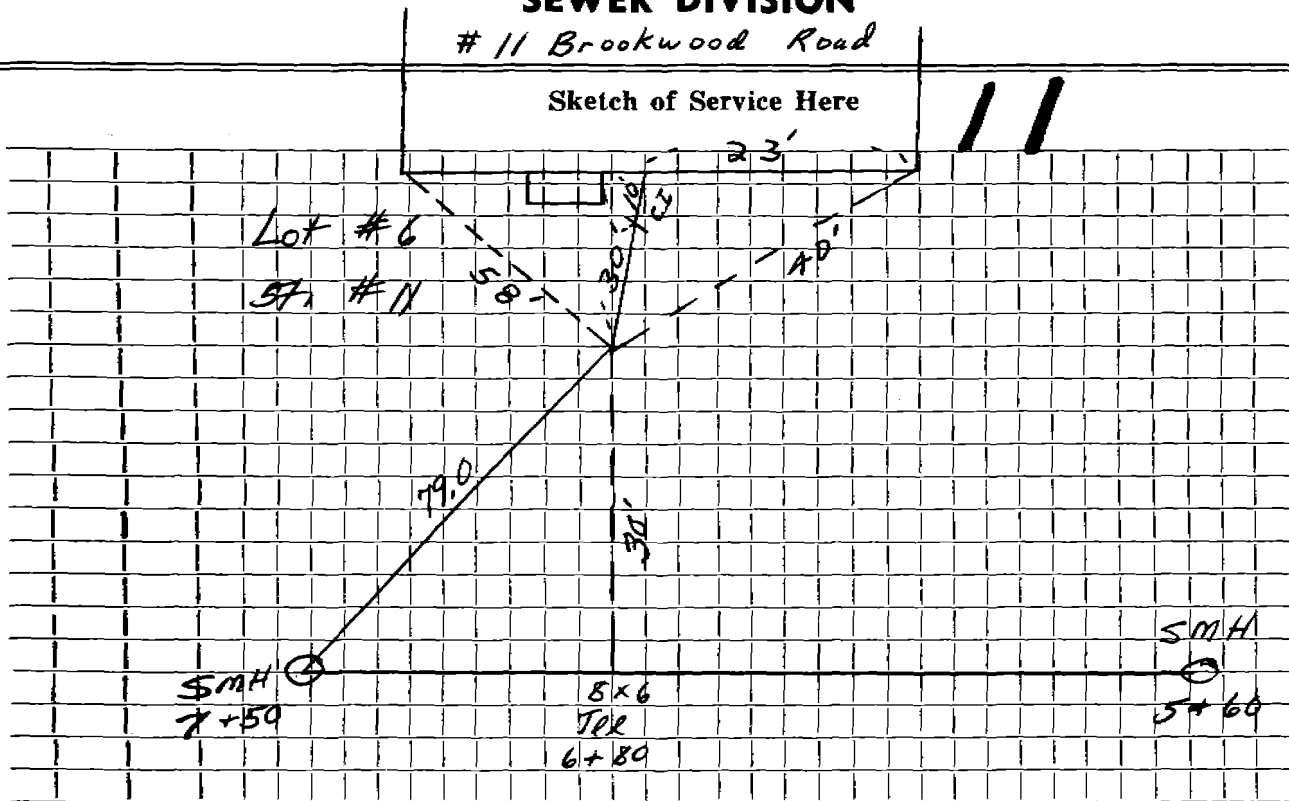

Connection made in Street. Work completed

Remarks:
.....
.....