




DATE \_\_\_\_\_

TOWN OF LEXINGTON — BOARD OF PUBLIC WORKS

SEWER DIVISION

7 BROOKWOOD  
Sketch of Service Here

7

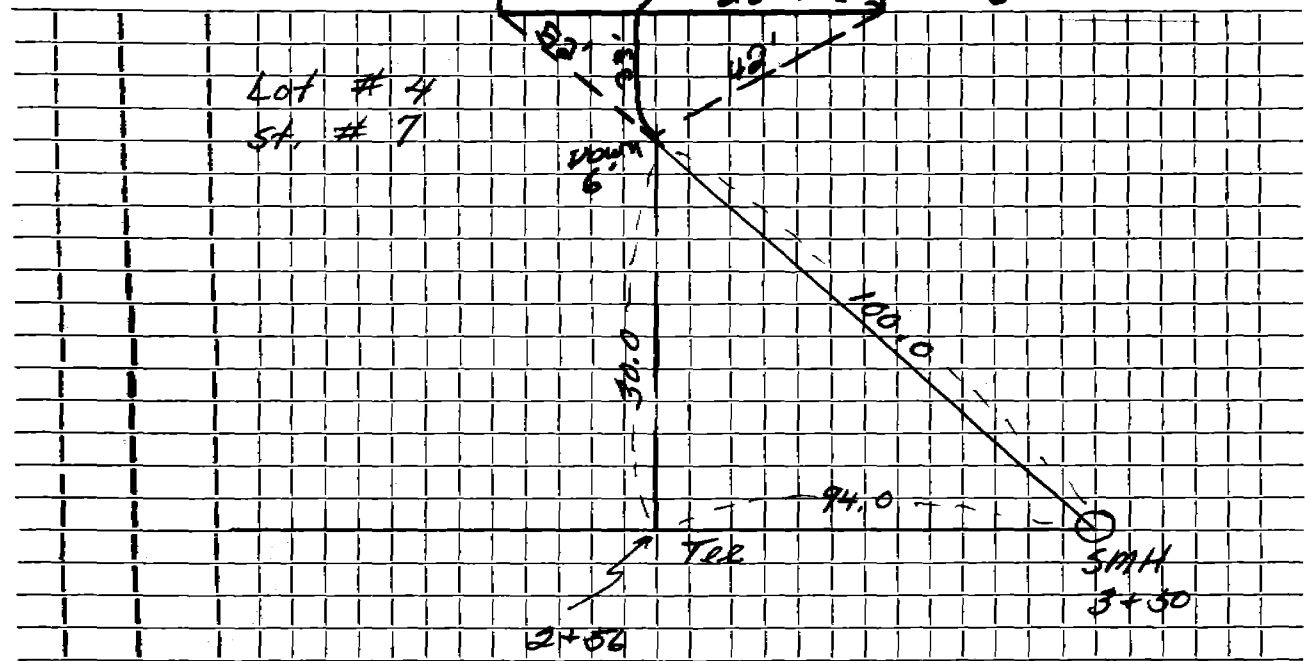

Connection made in Brookwood Rd. Street. Work completed 12/6/74

Remarks: .....

.....

.....