

Name *Jane Carrigg*

Service No. 26

Address 3 Brown Road

Location

Kind of Pipe

Size

Size of Main

~~Repair - Renewal~~ New Service Valeri #4337

Location SEP 5 1986


| Date | Material | Amount | Total | Date | Amount |
|-----------------|----------------------------|--------|--------|--------------------|----------------|
| 1967 | 25' 6" Transite pipe @6.00 | | 150.00 | 8-11-86 | <i>Deposit</i> |
| 8/26/86 | 108' 6" PVC | | | | |
| | 6' 4" Cast | | | 1967 | |
| | 1 A.C. to P.V.C. Adpt. | | | 25' | 6" Transite |
| | 2 Wye Cleanouts | | | | |
| | 2 22° Sweeps | | | | |
| | 1 4 x 6 Fernco | | | | |
| | 1 22° Bend | | | | |
| | 1 45° Bend | | | | |

DATE _____

TOWN OF LEXINGTON — BOARD OF PUBLIC WORKS

SEWER DIVISION

Sketch of Service Here **3**

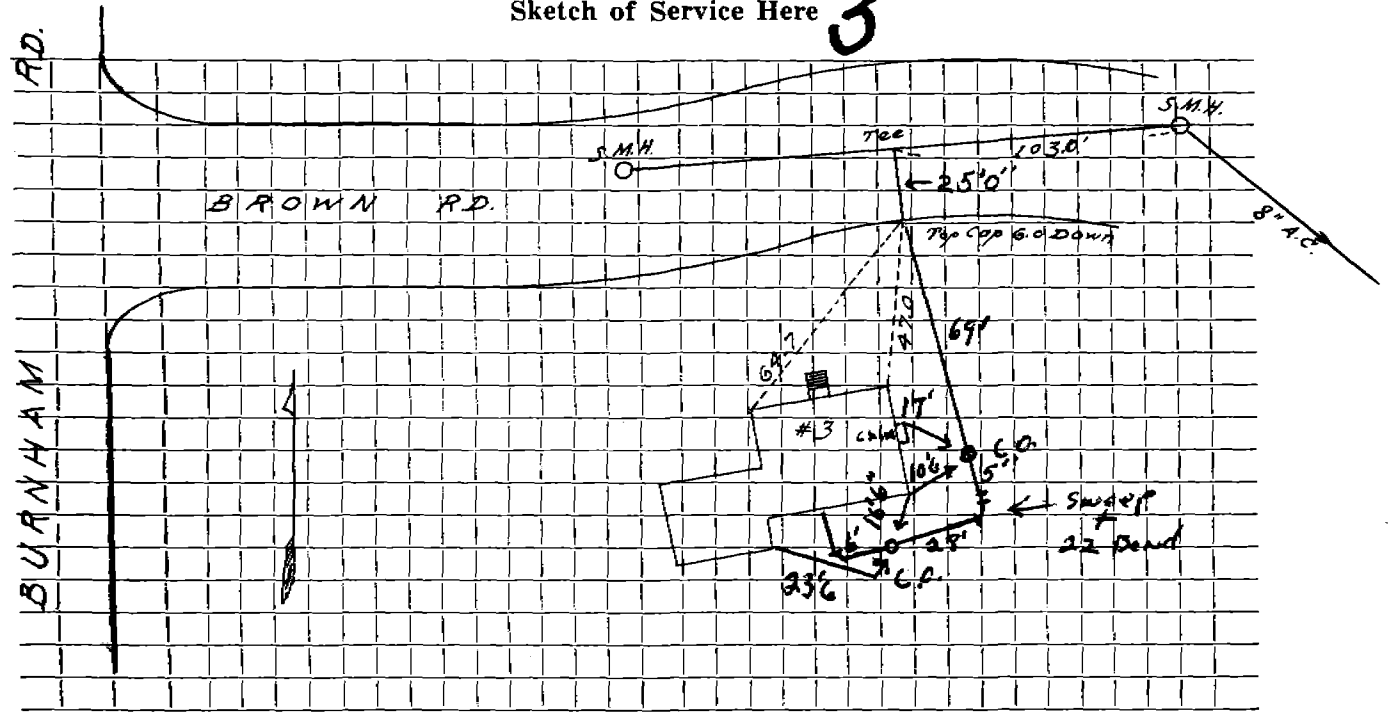

Connection made in Street. Work completed

Remarks:
.....
.....