




DATE \_\_\_\_\_

**TOWN OF LEXINGTON — BOARD OF PUBLIC WORKS**  
**SEWER DIVISION**

Sketch of Service Here **6**

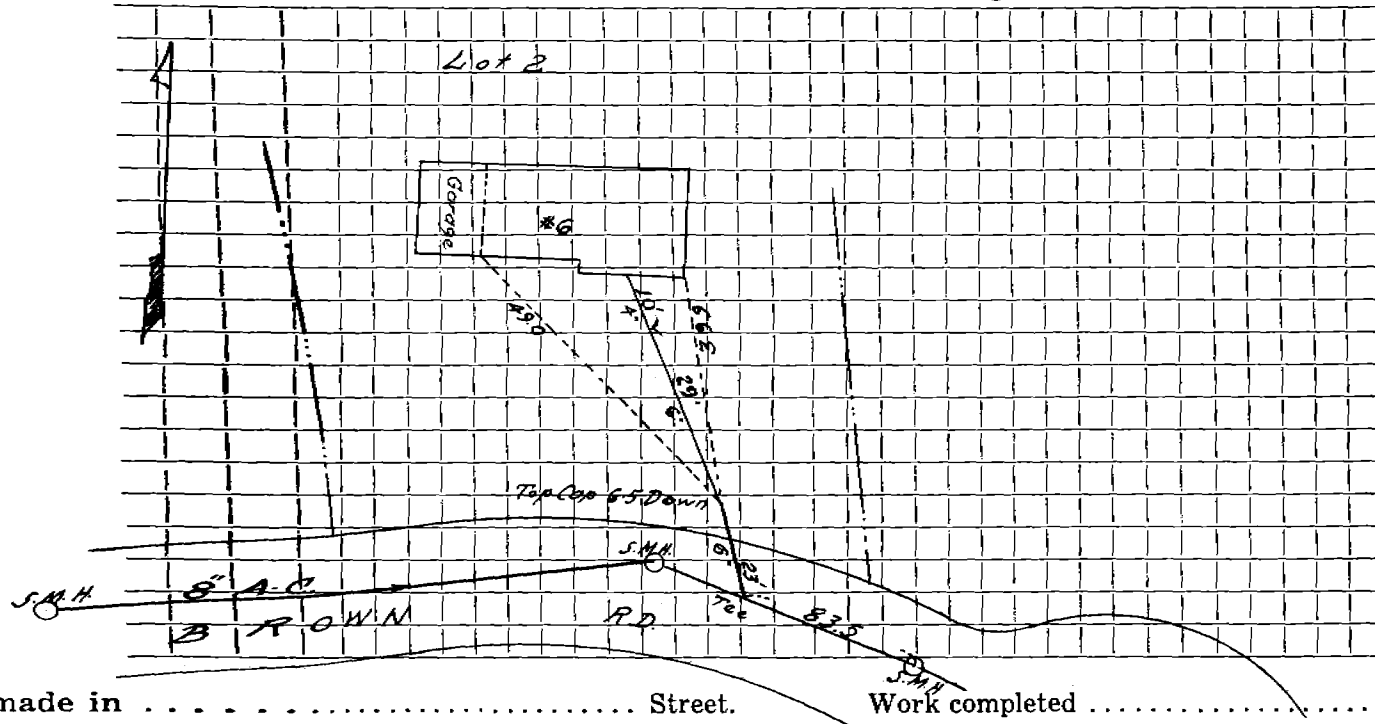

Connection made in . . . . . Street. Work completed . . . . . Street.

Remarks: . . . . .

. . . . .

. . . . .