




DATE \_\_\_\_\_

**TOWN OF LEXINGTON — BOARD OF PUBLIC WORKS**  
**SEWER DIVISION**

Sketch of Service Here

20

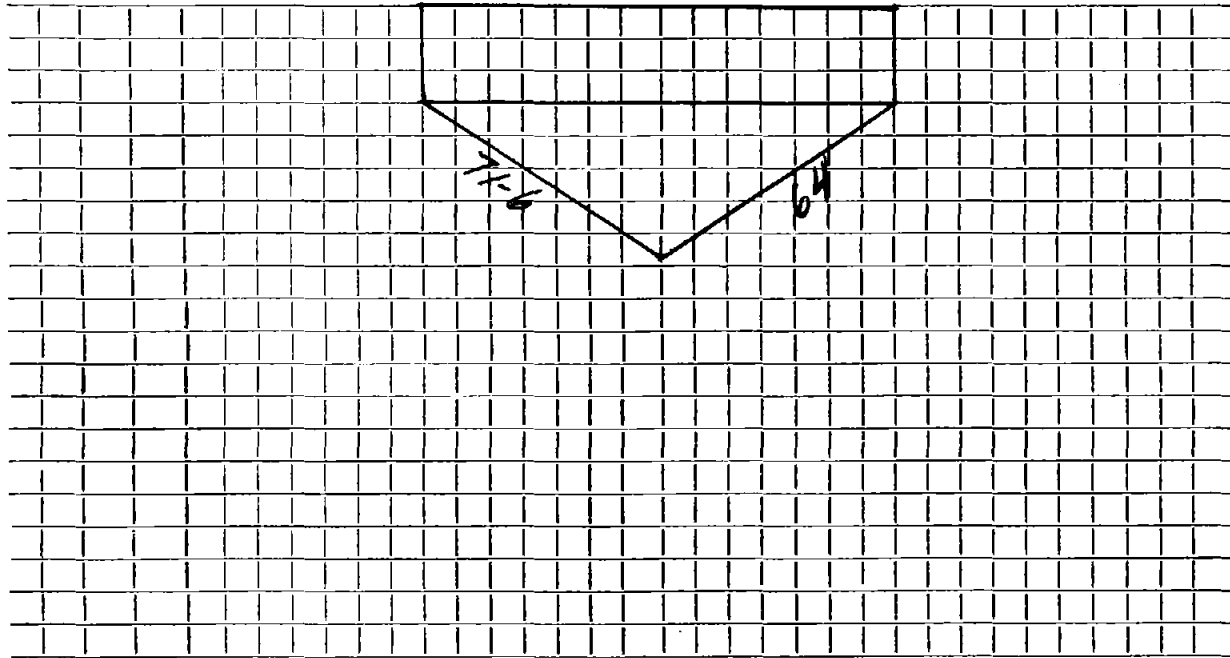

Connection made in ..... Street.      Work completed .....

Remarks: .....

.....  
.....