

Name DeVries Const. Co.

Service No. 78

Address 6 Bryant Road

Location

Kind of Pipe

Size

Size of Main

~~Repair~~ ~~Renewal~~ — New Service


Location *Comm 7-560*

Date	Material	Amount	Total	Date	Amount
10-3-59	Labor	8 13		5-17-60	130 00
	10% O. H.	81	8 94	7-5-60	79 38
	INSTALLED BY OWNER				50 62
	LABOR FOR SUPERVISION			2-18-62	Main Blockage
5-25-60	Labor	19 56			
	10% O.H.	1 96	21 52		
	22' 6" Transite pipe @78		17 16		
	1 Hr. Trucking @3.00		3 00		
			50 62		
				#	Applied to S/H #38 43
				#	" " " #40 42 44
				#	" " W/H #39 14 17
				#	" " " #37 15 91
				#	" " " #38 6 43

DATE _____

TOWN OF LEXINGTON — BOARD OF PUBLIC WORKS
SEWER DIVISION

Sketch of Service Here **6**

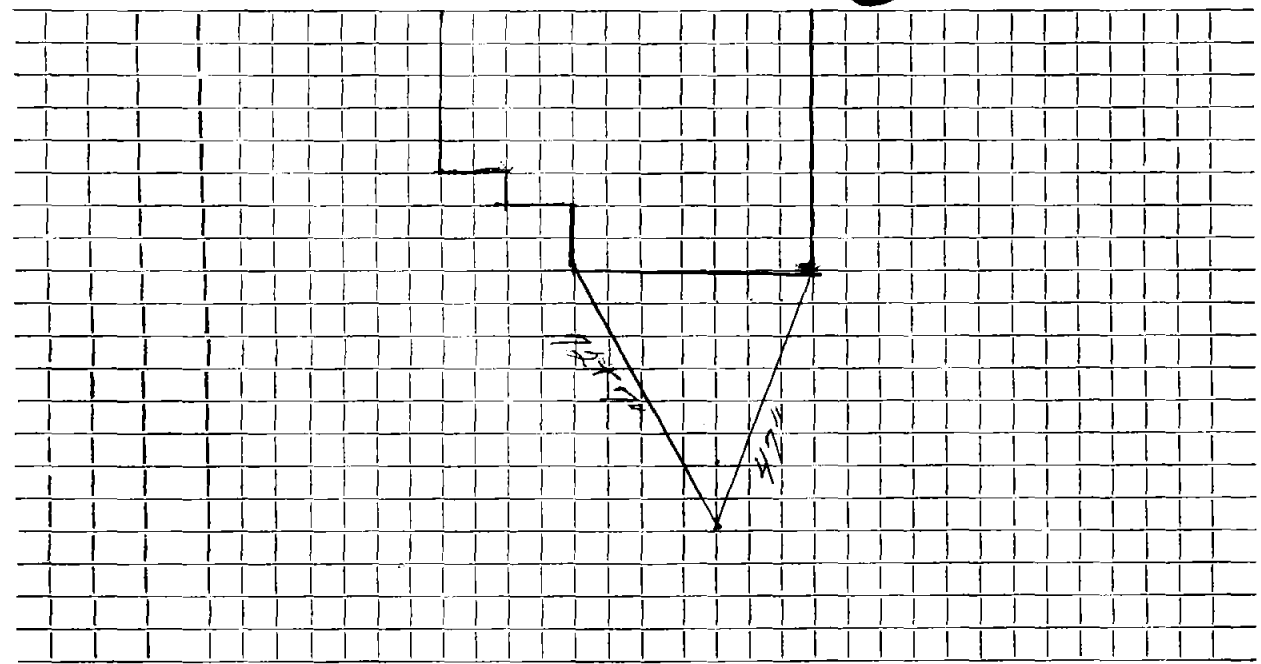

Connection made in Street. Work completed

Remarks:
.....
.....