

Name

Service No.

Address 7 Bryan Rd

Location

Kind of Pipe

SPR 35

Size

6" PVC

Size of Main

Repair—Renewal—New Service

Location

Date

Material

Amount

Total

Date

Amount


9/16

7' deep ferro
4x6 ferro
4" clearout
6" PVC

DATE 9/2016

TOWN OF LEXINGTON — BOARD OF PUBLIC WORKS
SEWER DIVISION

Sketch of Service Here

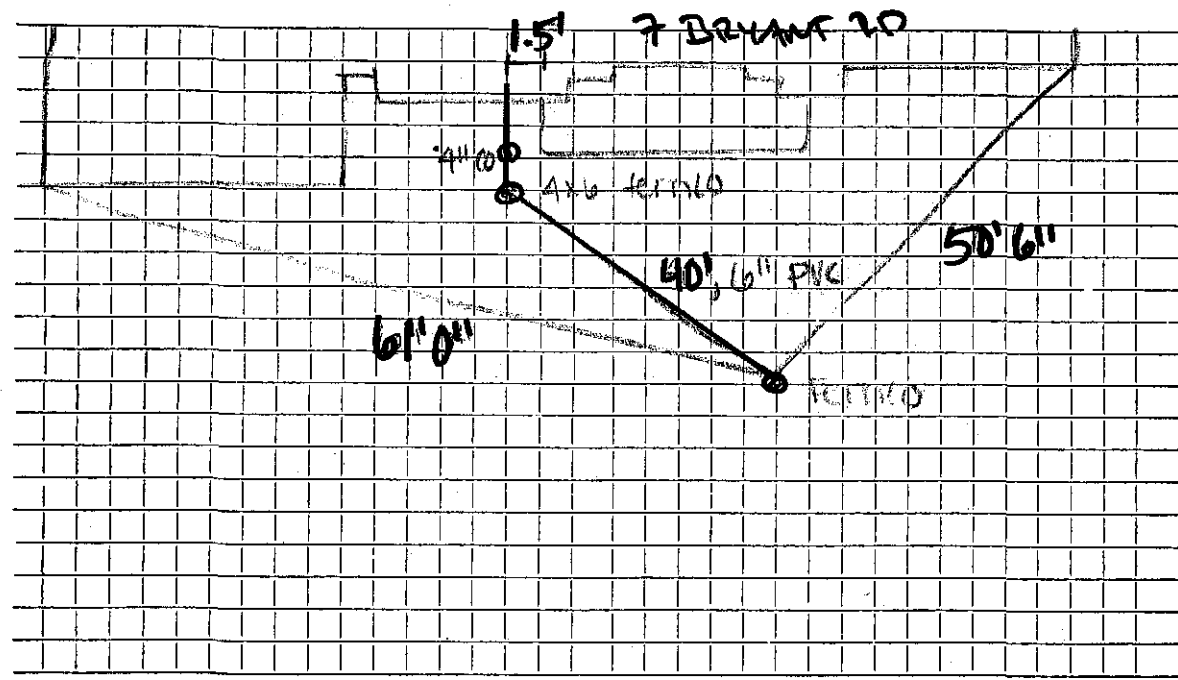

Connection made in Street. Work completed

Remarks:
.....
.....