

Name

Service No.

Address

8 Bryant

Location

Kind of Pipe

Size

Size of Main

Repair—Renewal—New Service

Location

Date

Material

Amount

Total

Date

Amount


10-3-59

Installed by owner

DATE _____

TOWN OF LEXINGTON — BOARD OF PUBLIC WORKS
SEWER DIVISION

Sketch of Service Here

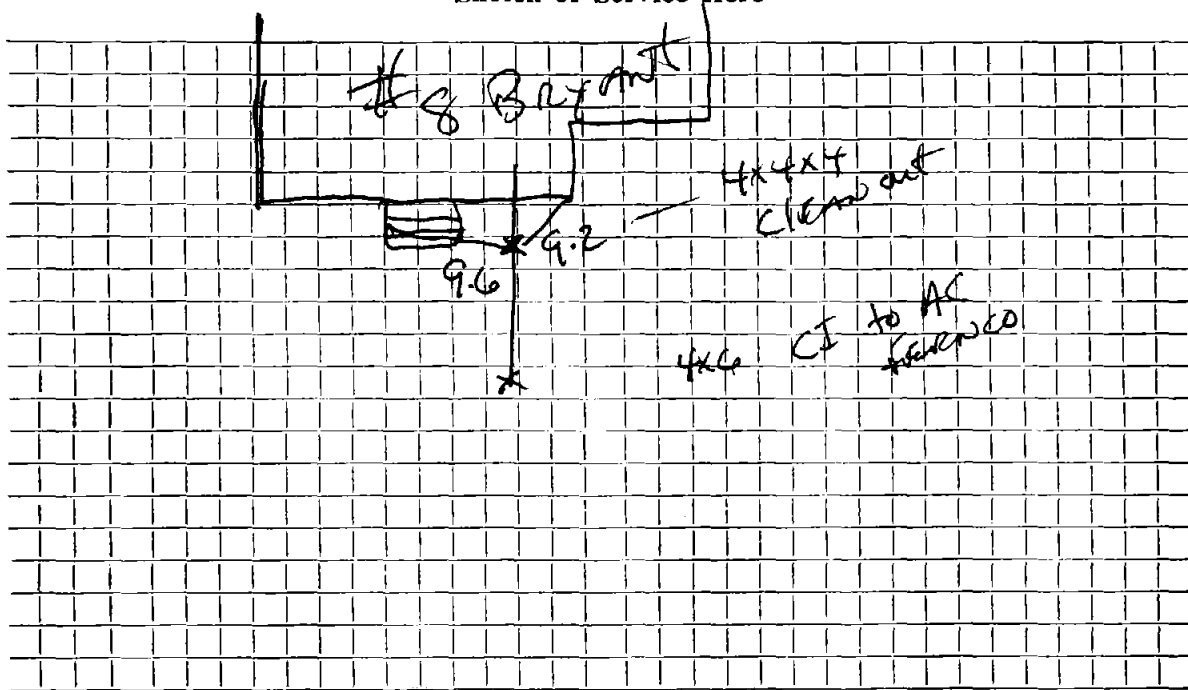

Connection made in _____ Street. Work completed _____

Remarks: Repair made to connection at CI