


DATE _____

TOWN OF LEXINGTON — BOARD OF PUBLIC WORKS

SEWER DIVISION

Sketch of Service Here **11**

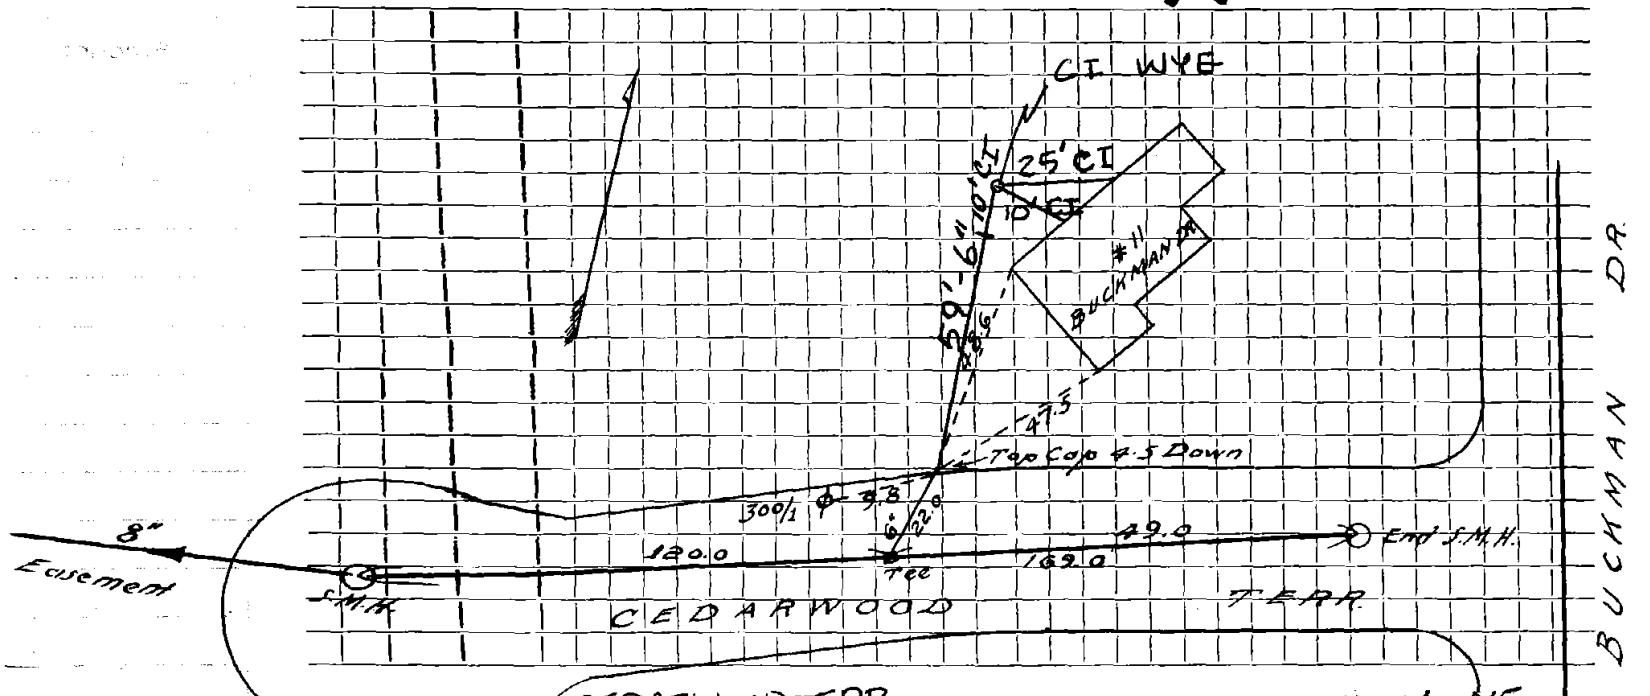

Connection made in CEDARWOOD TERR. Street. Work completed ... 11-14-45

Remarks:

.....

.....