

Name Alfred E. Oliva

Service No. 125

Address 20 Buckman Drive

Location

Kind of Pipe Lexington Sewerage Co. Permit #428 Size

Size of Main

Repair—Renewal—New Service

Location

SEP 27 1965


Date	Material	Amount	Total	Date		Amount
1965	27½' Transite pipe @7.00 installed by contractor		192 50	8-9-65	Deposit	192 50
8-11-65	36' 6" Transite pipe					

DATE _____

TOWN OF LEXINGTON — BOARD OF PUBLIC WORKS

SEWER DIVISION

Sketch of Service Here **20**

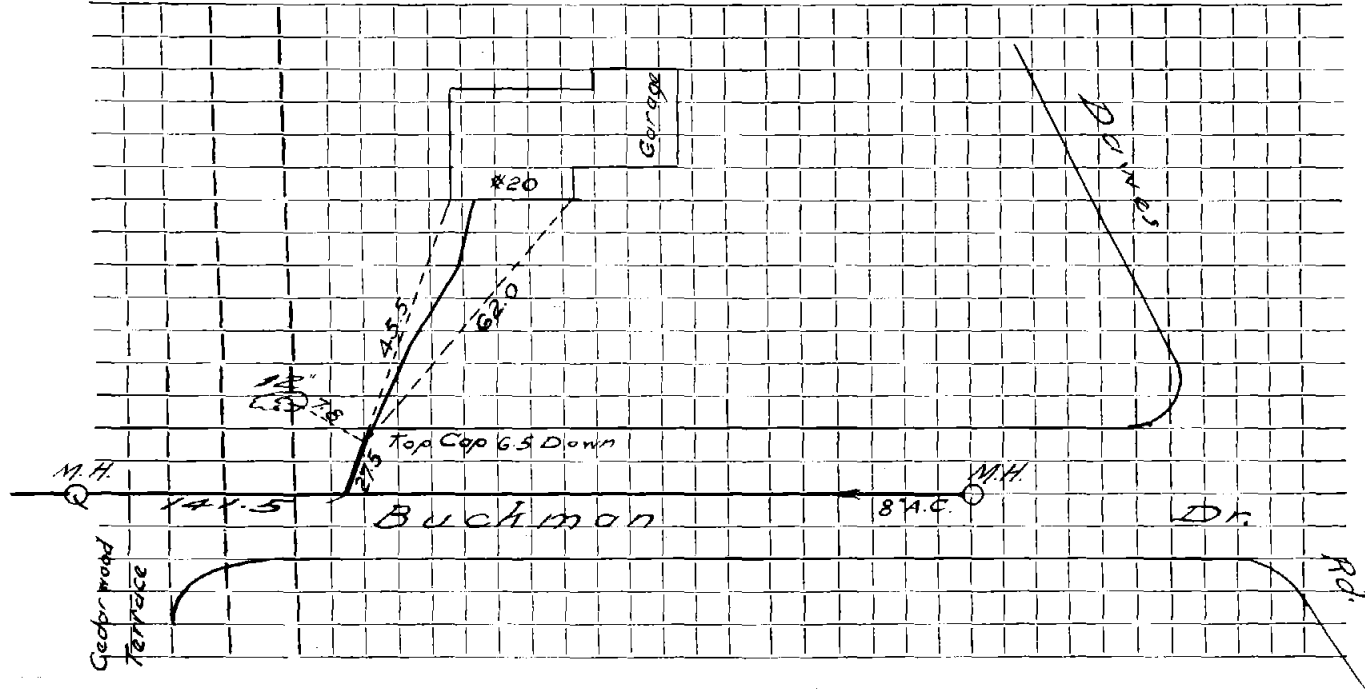

Connection made in Street. Work completed

Remarks:
.....
.....