

Name Joseph Pires

Service No. 37

Address 24 Buckman Drive

Location

Kind of Pipe

Size

Size of Main

~~Service No. 1234~~ New Service Daniels Equip. #3724

Location SEP 21 1981


Date		Material	Amount	Total	Date		Amount
1965	30'	Transite pipe @7.00 installed by contractor		210 <sup>00</sup>	9-11-81	Deposit	210 <sup>00</sup>
9/24/81	36'	6" P.V.C.					
	10'	4" Iron A.C. to P.V.C Adapter					
	1	6 x 4" Donut 1/2" Stone at pipe					

DATE \_\_\_\_\_

TOWN OF LEXINGTON — BOARD OF PUBLIC WORKS

SEWER DIVISION

Sketch of Service Here **24**

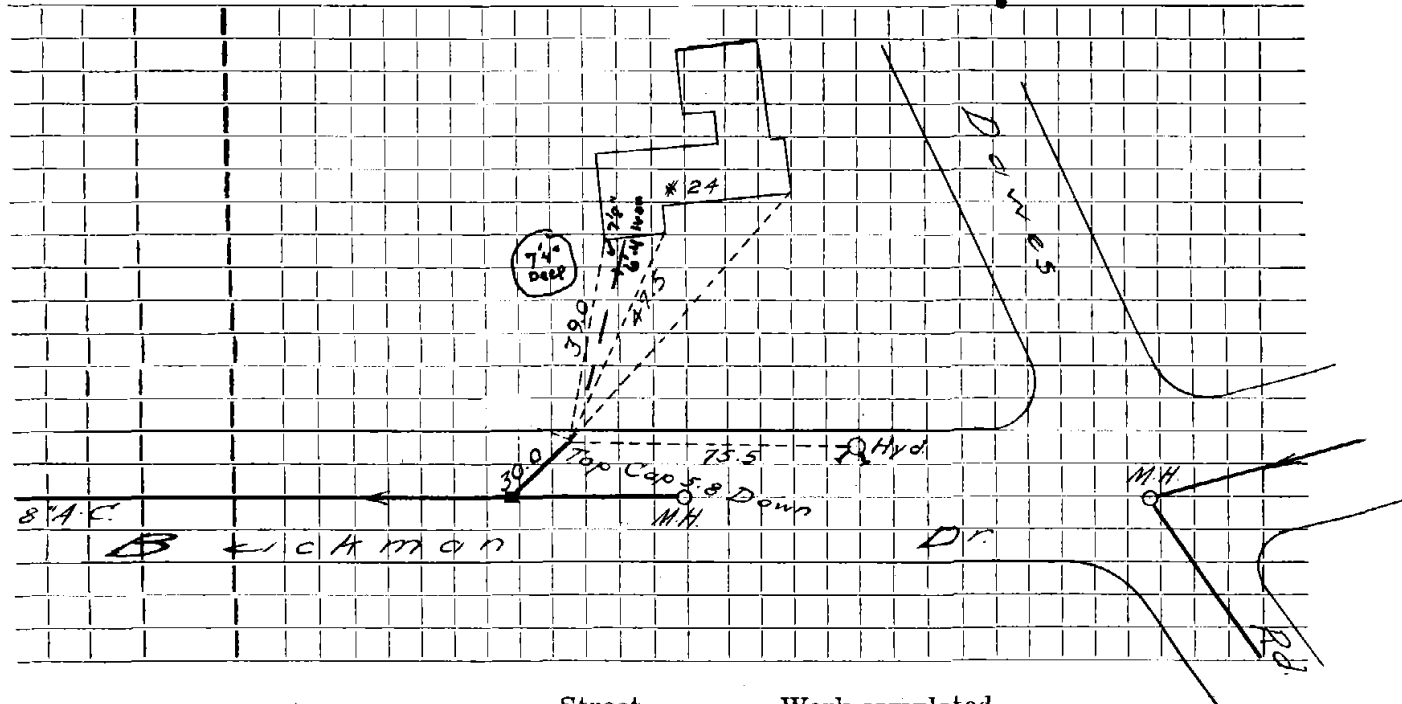

Connection made in ..... Street. Work completed .....

Remarks: .....  
.....  
.....