

Name Michael J. Spinelli

Service No. 242

Address 32 Buckman Drive

Location

Kind of Pipe

Size

Size of Main

~~Repair - Renewal~~ New Service T.D. Sullivan Permit #A121

Location JUL 25 1966

Date	Material	Amount	Total	Date	Amount
------	----------	--------	-------	------	--------

1965	18'	Transite pipe @ 7.00 installed by contractor	126 00	11-22-65	126 00
------	-----	---	--------	----------	--------

Deposit


126 00

DATE _____

TOWN OF LEXINGTON — BOARD OF PUBLIC WORKS

SEWER DIVISION

Sketch of Service Here **32**

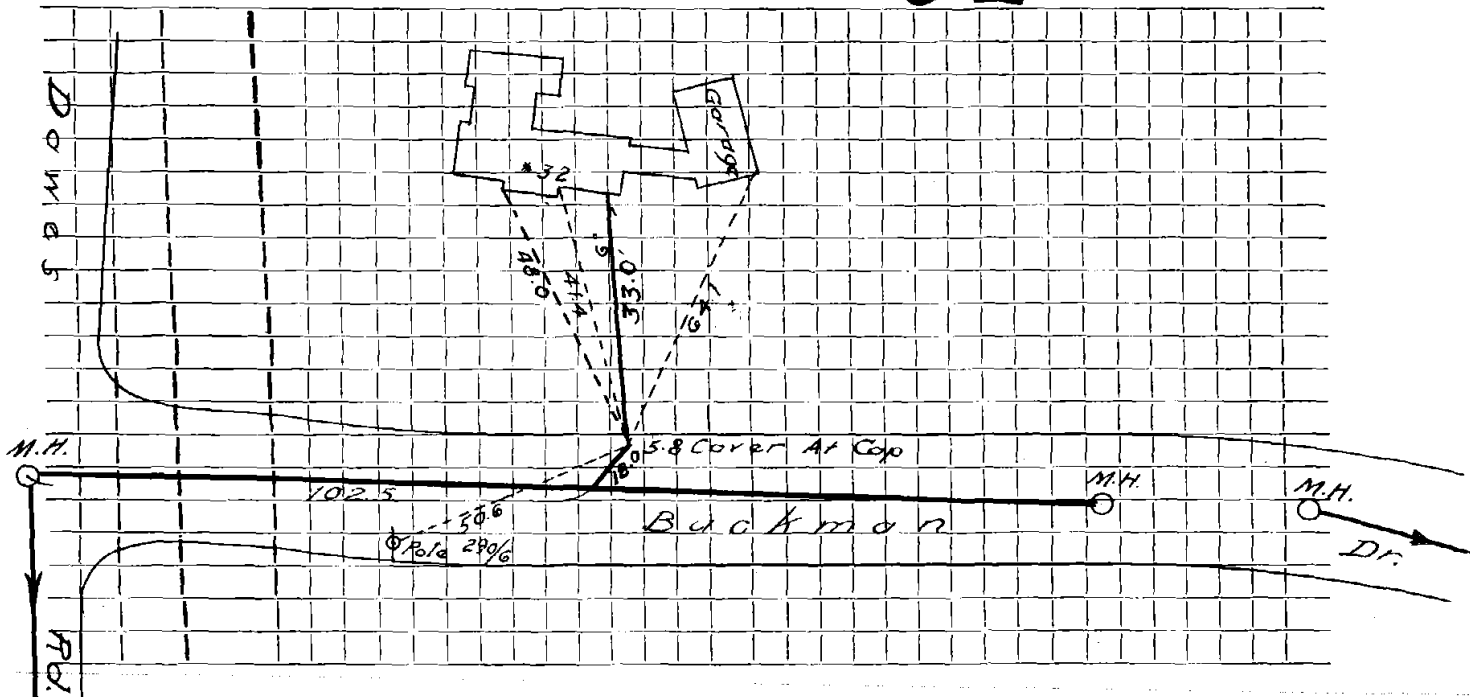

Connection made in Street. Work completed

Remarks:
.....
.....