


DATE 11-27-96

TOWN OF LEXINGTON — BOARD OF PUBLIC WORKS
SEWER DIVISION

Sketch of Service Here
47 BUCKMAN 47

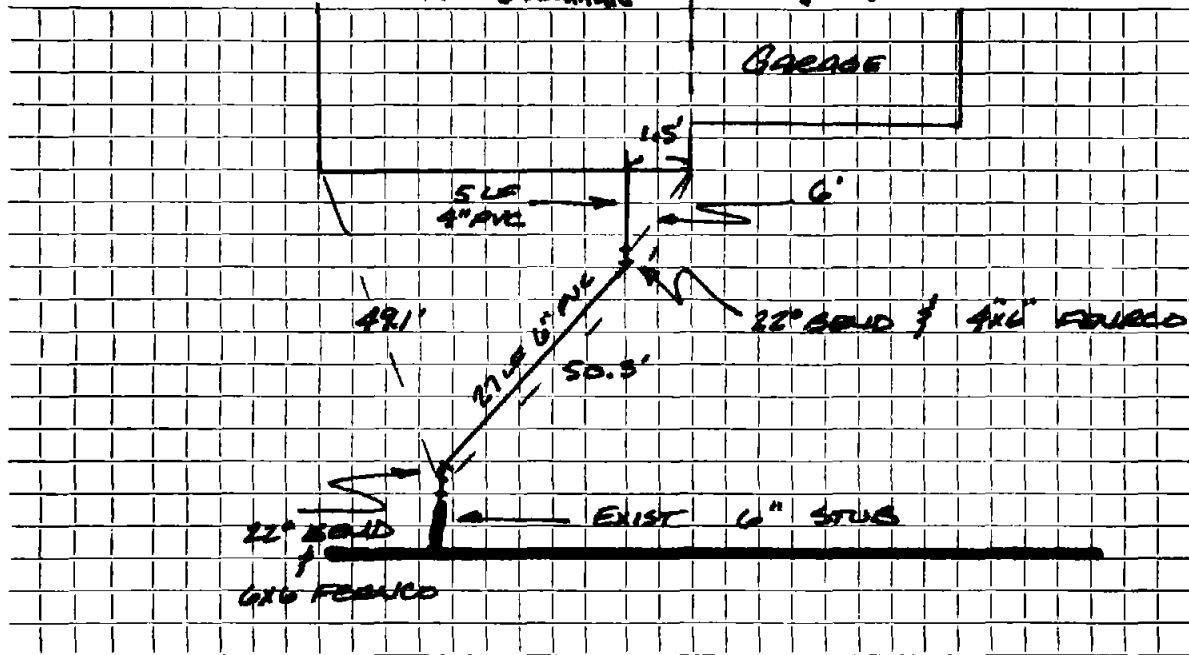

Connection made in BUCKMAN DRIVE Street. Work completed ARLEX OIL COOP.

Remarks:

N.B. 1996.5 Pg. 14

DONE JM