

Name

Service No.

Address 53 Buckman Drive

Location

Kind of Pipe

Size

Size of Main

Repair—Renewal—New Service ARLEX

Location


Date	Material	Amount	Total	Date	Amount
1965	14' Transite pipe @7.00		98 00		
	installed by contractor				
6/22/99	BACK of house JWB BR			1965	
	13' 6" PVC			14' 6" Transite	
	2 WYE CLEAN OUTS				
	1 1 1/2" Fernco				
	1 6" 22° BEND				
	96' 6" PVC				

DATE _____

TOWN OF LEXINGTON — BOARD OF PUBLIC WORKS
SEWER DIVISION

Sketch of Service Here

53

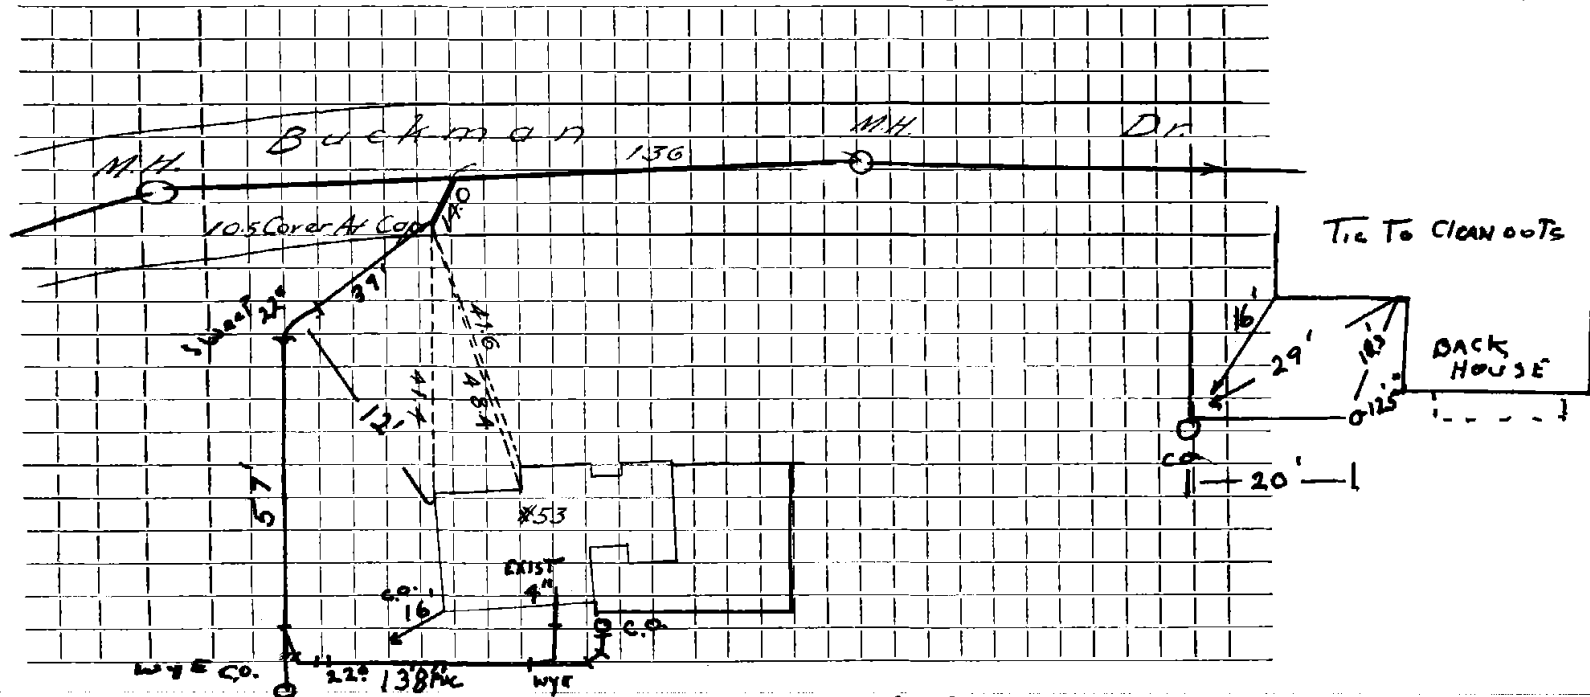

Connection made in _____ Street. Work completed _____

Remarks: Back in 1972. — ST. To back ST. STEEL PLATE OVER CLEANOUTS.