

Name Robert L. Snuggs Jr.

Service No. 49

Address 54 Buckman Drive

Location

Kind of Pipe

Size

Size of Main

FEB 27 1984

Repair—Renewal—New Service McKee #3852

Location

Date	Material	Amount	Total	Date	Amount
------	----------	--------	-------	------	--------

1965	22' Transite pipe @7.00 installed by contractor		154 00	10/3/84	Deposit 154.00
------	--	--	--------	---------	----------------

11/3/83	84' 6" P.V.C.			1965	
	5' 4" Cast Iron			22'	6" Transite


DATE \_\_\_\_\_

# TOWN OF LEXINGTON — BOARD OF PUBLIC WORKS

## SEWER DIVISION

Sketch of Service Here

# 54

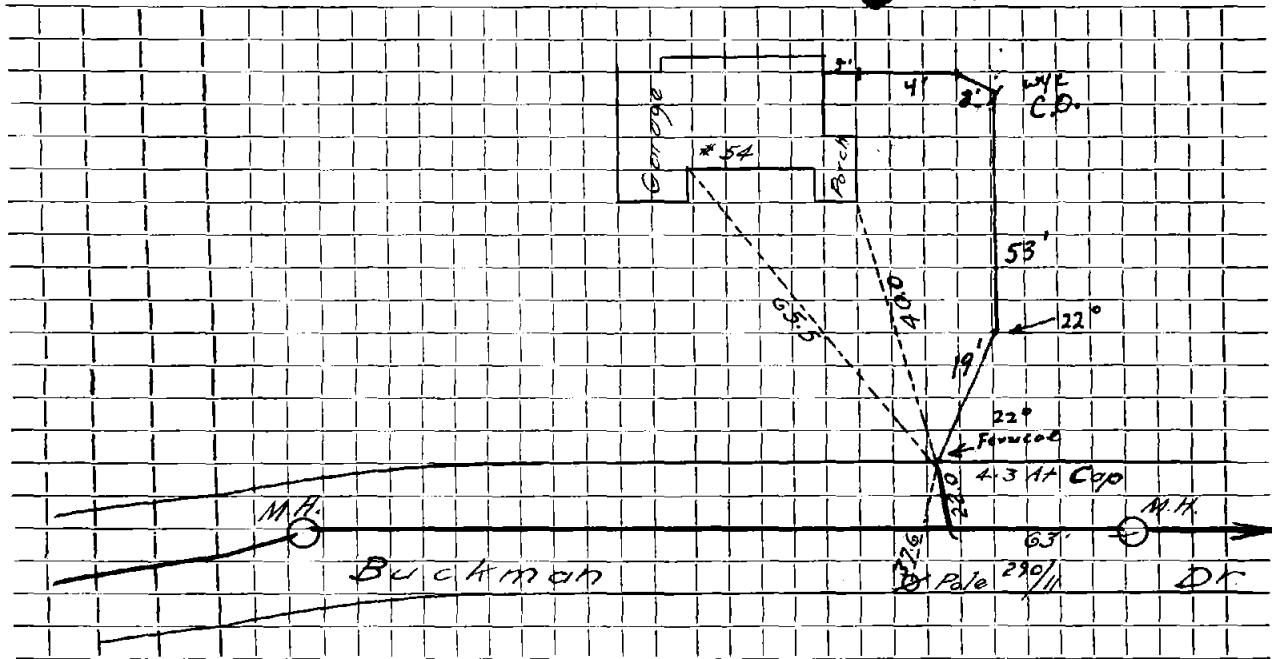

Connection made in ..... Street.      Work completed .....

Remarks: .....  
.....  
.....