

Name Ben Gomes-Casseres
 Address 58 BUCKMAN DRIVE

Service No. _____

Location _____

Kind of Pipe PVC & CI

Size 4" & 6"

Size of Main 8"

Repair—Renewal—New Service Arlex #0187

Location _____


Date	Material	Amount	Total	Date	Amount
6/3/92	133 LF 6" PVC			6-3-92	Paid
	9 LF 4" CI				
	6" WYE CLEANOUT			1965	
	6" WYE			21' 6" Transite	
	2- 6" 22° BENDS				
	6" 45° BEND				
	2- 4" 6" FERNCOS				
	6" 6" FERNGO				
1965	21' Transite pipe & fittings		147.00		
	installed by contractor				

DATE _____

TOWN OF LEXINGTON — BOARD OF PUBLIC WORKS

SEWER DIVISION

Sketch of Service Here **58**

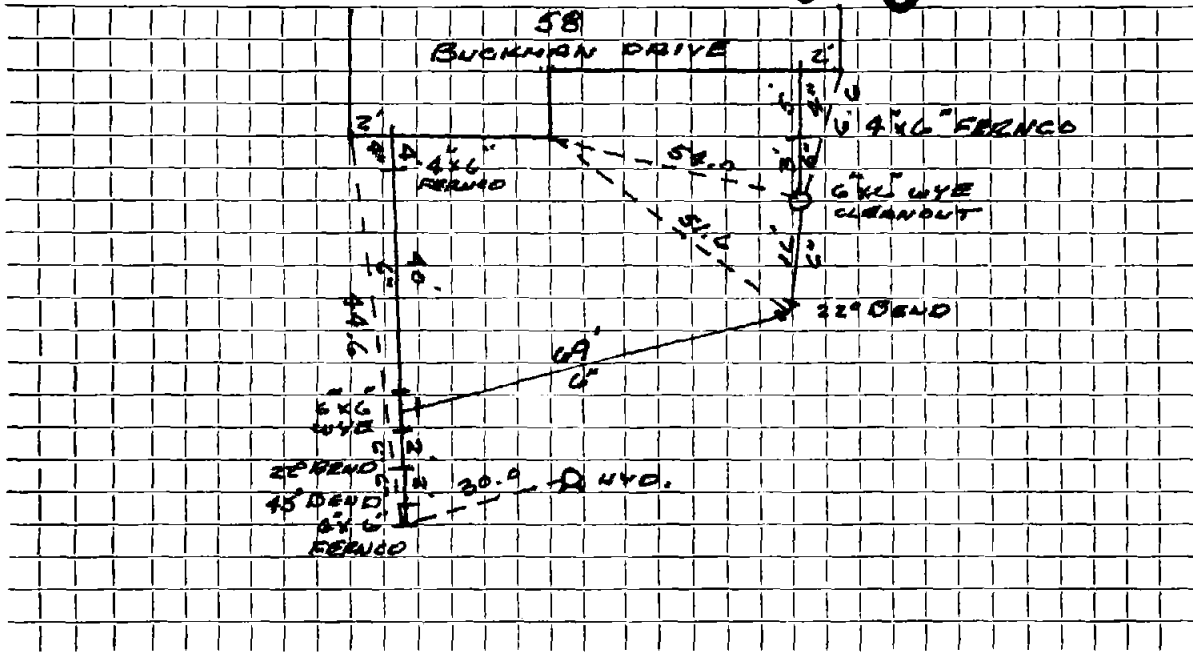

Connection made in BUCKMAN DRIVE Street. Work completed

Remarks: ARLEY CONTR.

.....
