

Name Isabell M. Gallagher

Service No. 97

Address 61 Buckman Drive

Location

Kind of Pipe

Size

Size of Main

Repair—Renewal—New Service Devine #1937

Location JUN 5 1972

Date

Material

Amount

Total

Date

Amount

~~1965~~ 21' Transite pipe @7.00
installed by contractor

147 00

11-5-71

Deposit

147 00

12-8-71 136' 6" Transite pipe

1965

50' 4" Cast Iron pipe


21' 6" Transite

DATE _____

TOWN OF LEXINGTON — BOARD OF PUBLIC WORKS
SEWER DIVISION

Sketch of Service Here

61

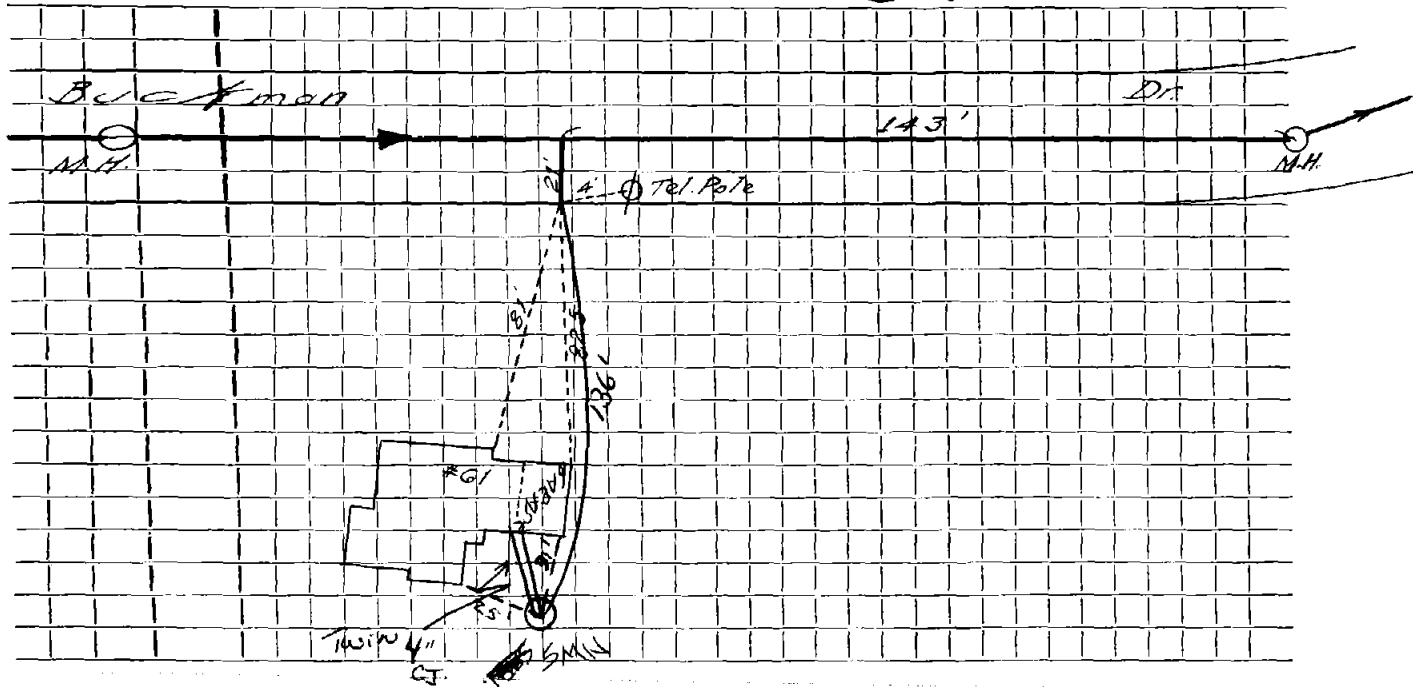

Connection made in Street. Work completed

Remarks:
.....
.....