




DATE \_\_\_\_\_

# TOWN OF LEXINGTON — BOARD OF PUBLIC WORKS

## SEWER DIVISION

Sketch of Service Here

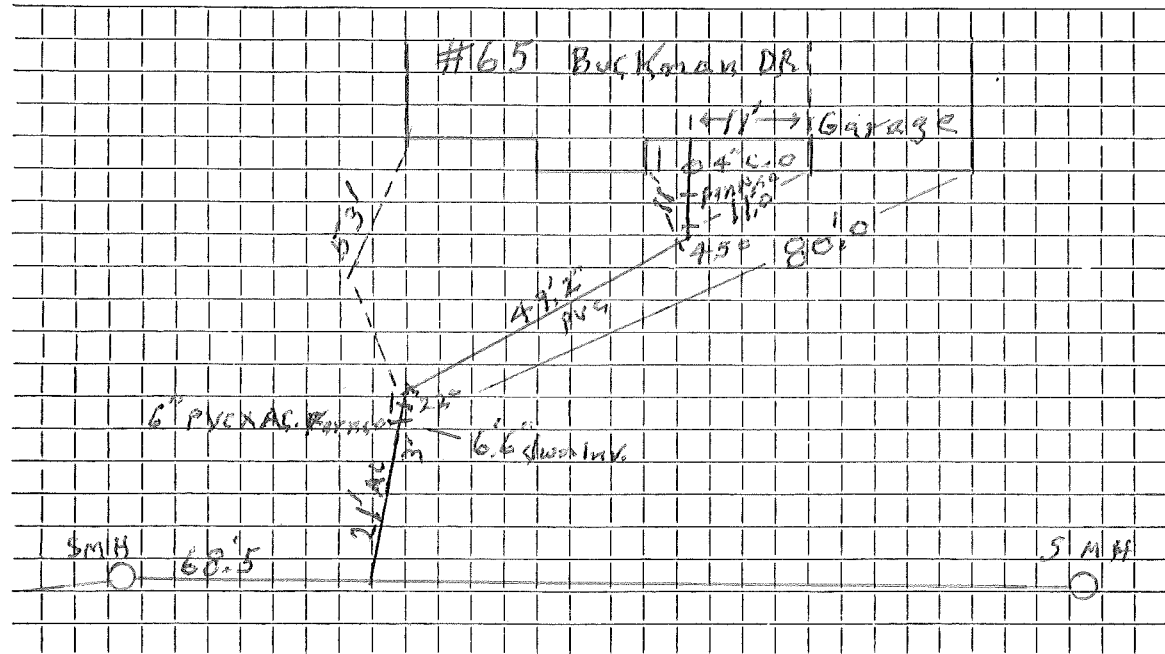

13.5 x PVC Ferrel  
 AC. Stub 3' to 22"  
 22" to 45" - 4 1/2"  
 45" to 4x6 Ferrel 5'  
 4x6 Ferrel to C.O. 4'  
 C.O. to house 2'

Connection made in Buckman Dr. Street.

Work completed 6/20/11 J. McLaughlin

Remarks: .....