

Name

Service No.

Address 66 Buckman Drive

Lot L.C. 69

Location

Kind of Pipe

Size

Size of Main

Repair—Renewal—New Service

Location

Date

Material

Amount

Total

Date

Amount

~~1965~~ 20' Transite pipe @7.00

140 00

installed by contractor

1965


20' 6" Transite

DATE \_\_\_\_\_

TOWN OF LEXINGTON — BOARD OF PUBLIC WORKS

SEWER DIVISION

Sketch of Service Here **66**

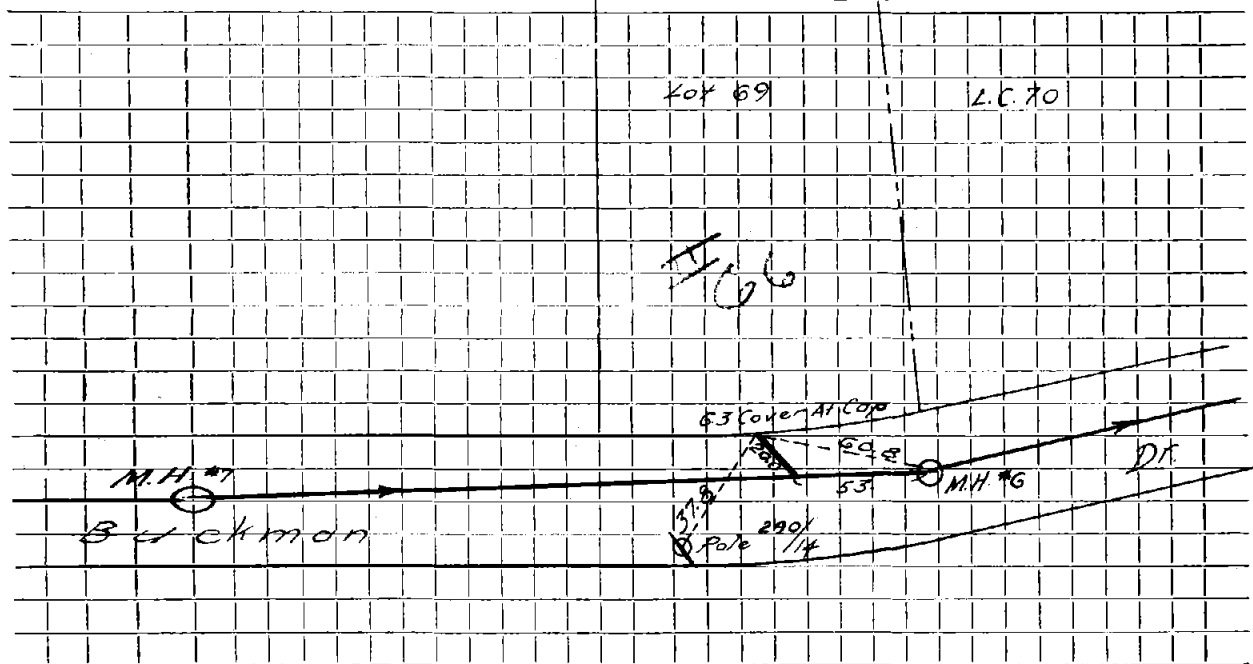

Connection made in ..... Street. Work completed .....

Remarks: .....  
.....  
.....