

Name Murray Zelikoff

Service No. 128

Address 70 Buckman Drive

Location

Kind of Pipe

Size

Size of Main

Repair—Renewal—New Service Lexington Sewerage #1282

Location

Date	Material	Amount	Total	Date	Amount
1965-21	Transite pipe @7.00 installed by contractor		147 00	12-12-68 <i>Deposit</i>	147 00
12-14-68	42' 6" Transite pipe			1965	
	10' 4" Cast Iron pipe			21' 6" Transite	


DATE _____

TOWN OF LEXINGTON — BOARD OF PUBLIC WORKS

SEWER DIVISION

Sketch of Service Here

70

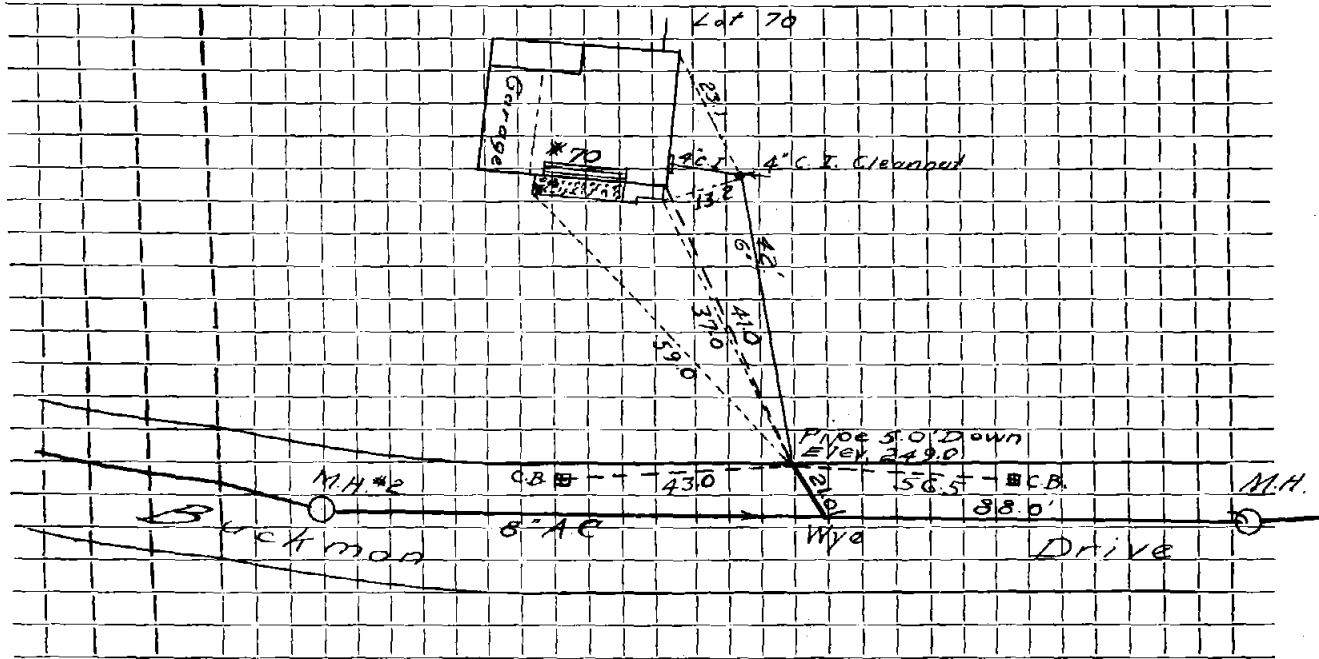

Connection made in Street. Work completed

Remarks:

.....

.....