

Name L. Leonard Tierney

Service No. 28

Address 76 Buckman Drive

Location

JUL 24 1978

Kind of Pipe

Size

Size of Main

Repair—~~RENEWAL~~ W.O. #6383

Location

Date	Material	Amount	Total	Date	Amount
6/14/78	Labor	138 78		6-14-78	200 00
	10% O.H.	13 88	152 66	6-23-78	37 71
1	5' Transite Nipple @1.75		8 75		237 71
1	4" Donut		3 05	1965	
1	1 1/2" Elbow		4 15	21' 6" Transite	
1	2 1/2" Elbow		10 50		
5	yds. Loam @ 5.44		27 20		
10	lbs. Seed @ .74		7 40		
1	bag of Lime		1 00		
1	bag Fertilizer		4 00		
2	hrs. Trucking @ 3.00		6 00		
2	hrs. Backhoe @ 6.50		13 00		
10-18-65			237.71		
	43' 6" Transite				
				6-12-78	Sewer Block (Dip in pipe)
				2-18-74	Sewer Block


DATE _____

TOWN OF LEXINGTON — BOARD OF PUBLIC WORKS

SEWER DIVISION

Sketch of Service Here

76

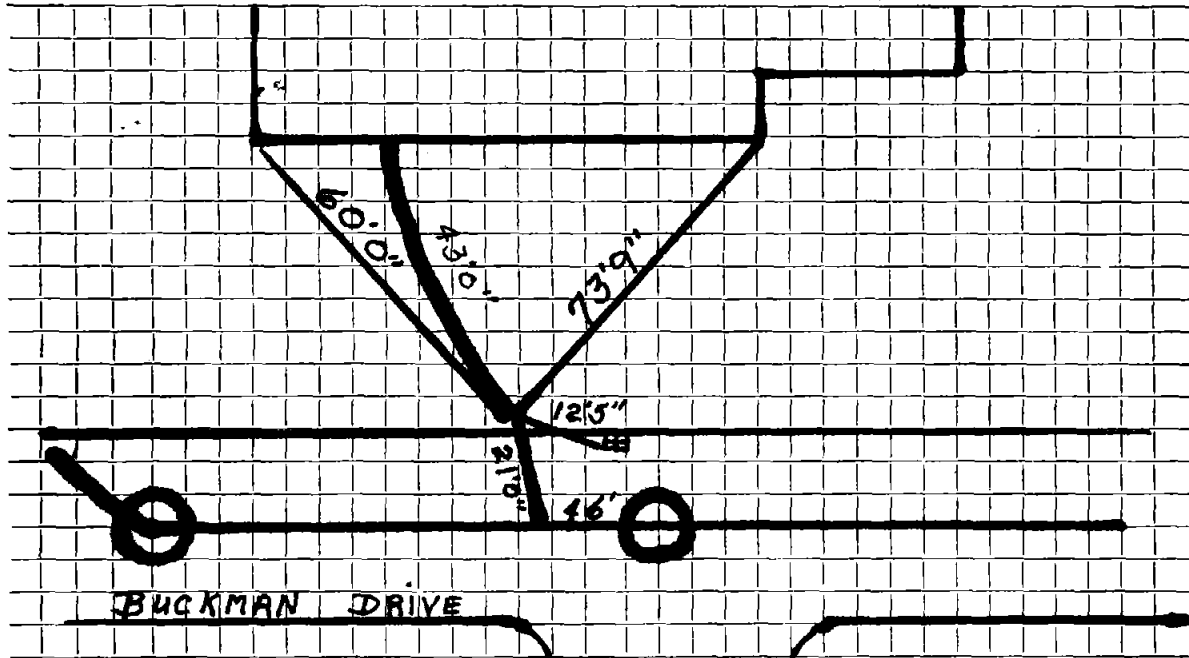

Connection made in Street. Work completed

Remarks:
.....
.....