

Name Lillian I. Jones

Service No. 123

Address 8 Buckman Drive

Location

Kind of Pipe Lexington Sewerage Permit #426

Size

Size of Main

Repair—Renewal—New Service

Location

SEP 27 1965

Date

Material

Amount

Total

Date

Amount

1965

29'

Transite pipe @7.00

203 00

8-5-65

Deposit

203 00

installed by contractor

7-9-65

37'


6" Transite pipe

V

DATE _____

TOWN OF LEXINGTON — BOARD OF PUBLIC WORKS
SEWER DIVISION

Sketch of Service Here **8**

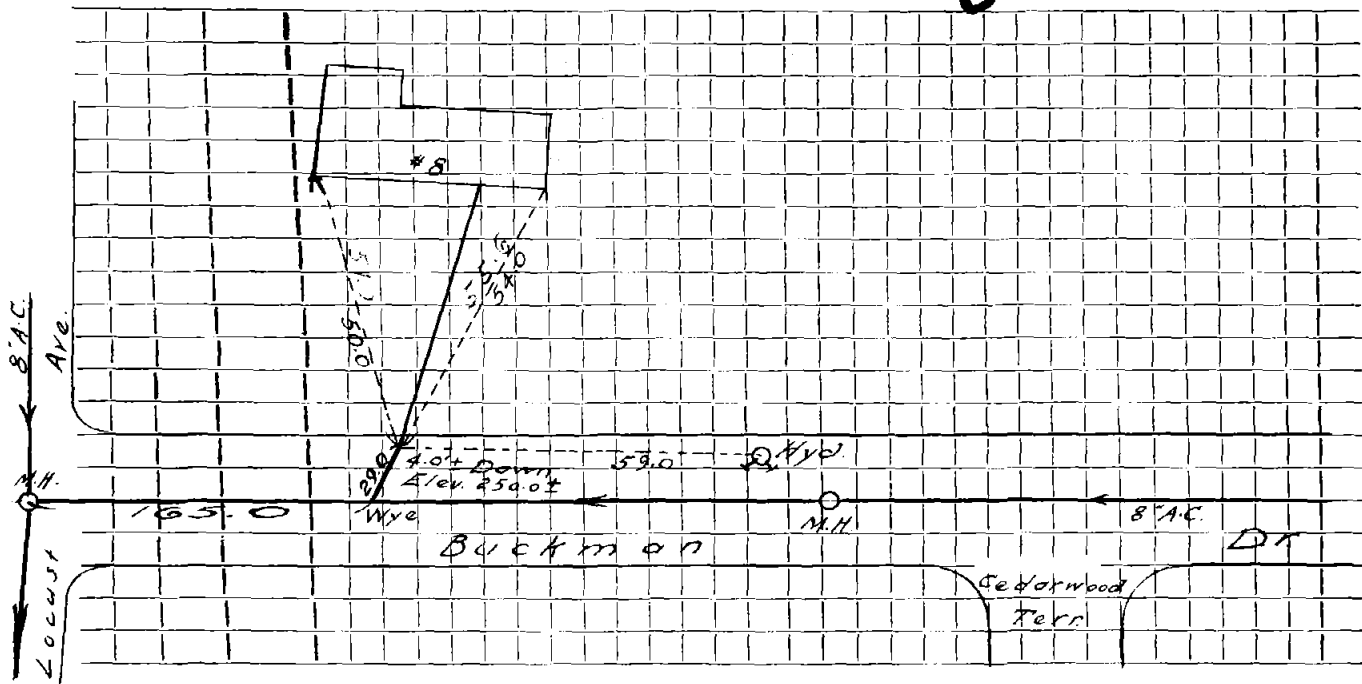

Connection made in Street. Work completed

Remarks:
.....
.....