

Name William G. Graham

Service No. 8

Address 80 Buckman Drive

Location

Kind of Pipe

Size

Size of Main

Repair—Renewal—New Service Valeri Const. #546

Location Cam 5-8-67

Date

Material

Amount

Total

Date

Amount

~~1965 28 1/2~~

~~Transite pipe @ 7.00~~

~~199 50~~

~~3-2-67~~

Deposit

~~199 50~~

3/13/67 15'

6" Transite pipe

1965

34'

4" Cast Iron Pipe


28.6

6" Transite

DATE _____

TOWN OF LEXINGTON — BOARD OF PUBLIC WORKS
SEWER DIVISION

Sketch of Service Here **80**

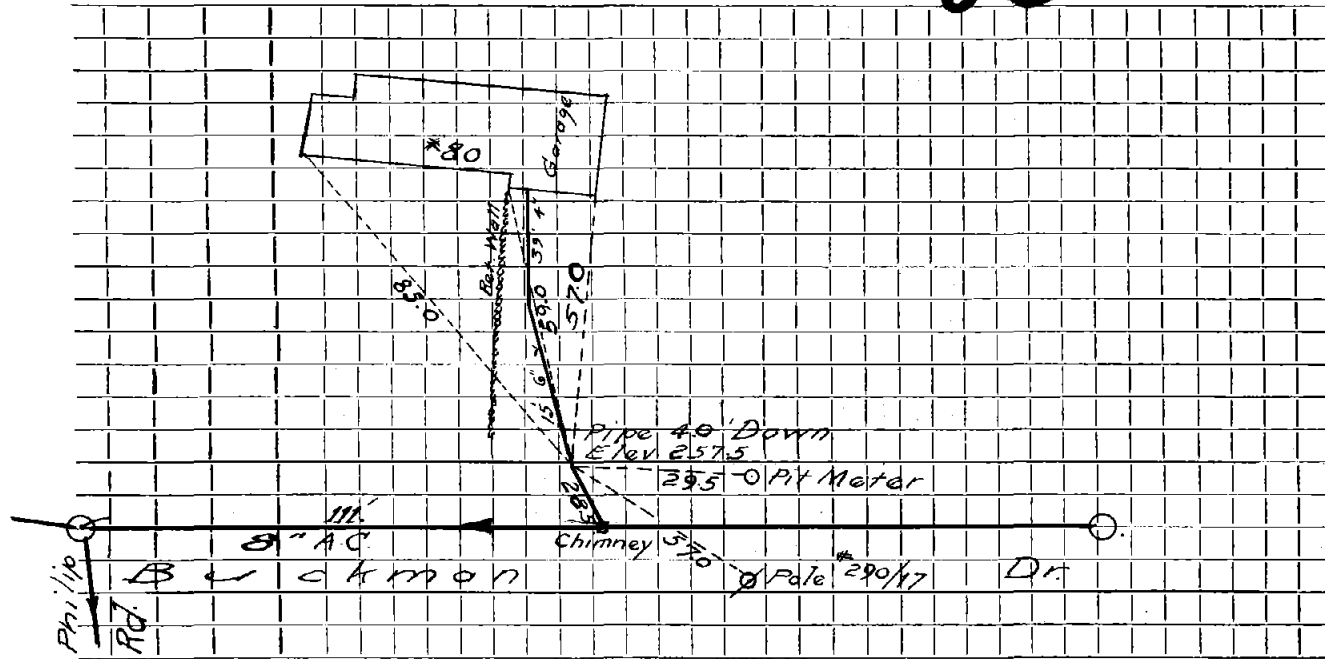

Connection made in Street. Work completed

Remarks:
.....
.....