

Name Eugene Luongo

Service No. 22

Address 82 Buckman Drive

Lot #10 & Pt. Lot #11

Location

Kind of Pipe

Size

Size of Main

~~Revised~~ ~~Change~~ New Service DeFlice Brothers # 3225

Location AUG 8 1979


Date	Material	Amount	Total	Date	Amount
1965	22.7' 6" Transite pipe @ 7.00		158.90	5/1/79	\$ 158.90
7/23/79	34' 6" Transite Pipe				
	10' 4" P.V.C.			1965	
				22' 6" Transite	

DATE _____

TOWN OF LEXINGTON — BOARD OF PUBLIC WORKS

SEWER DIVISION

Sketch of Service Here **82**

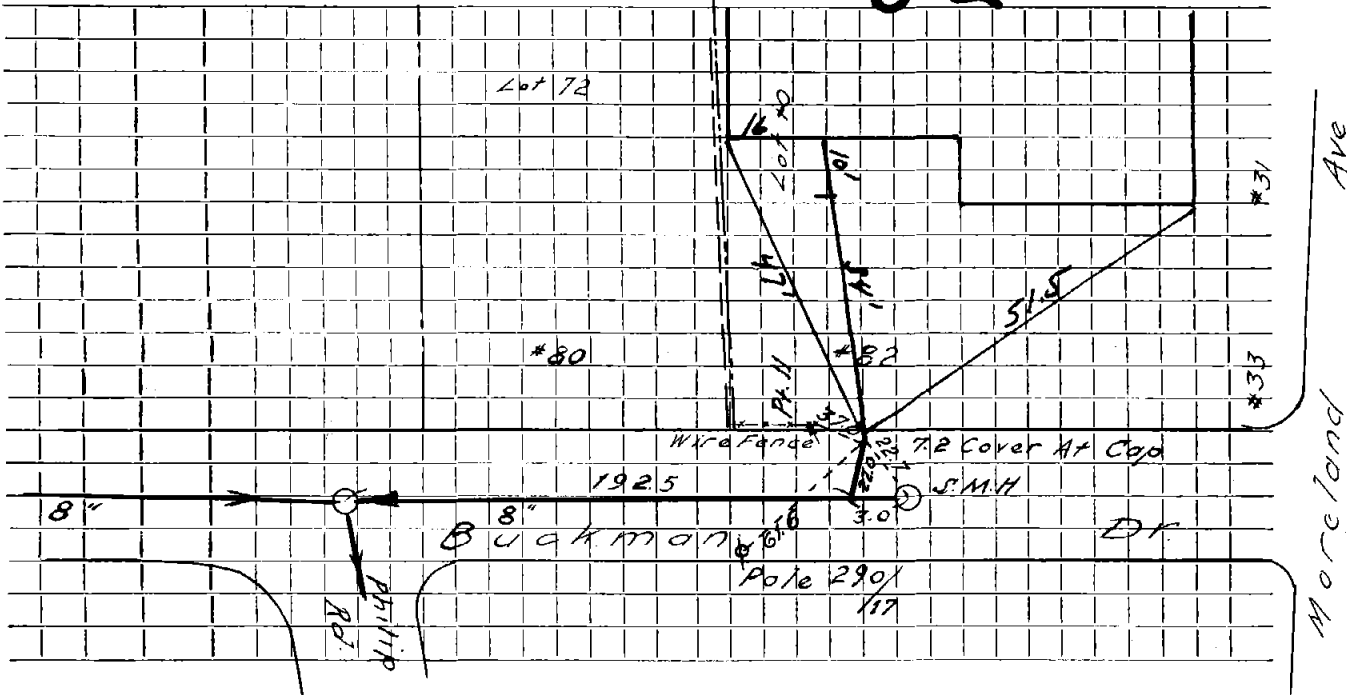

Connection made in Street. Work completed

Remarks:
.....
.....