


DATE _____

TOWN OF LEXINGTON — BOARD OF PUBLIC WORKS SEWER DIVISION

Sketch of Service Here

Lantson LA

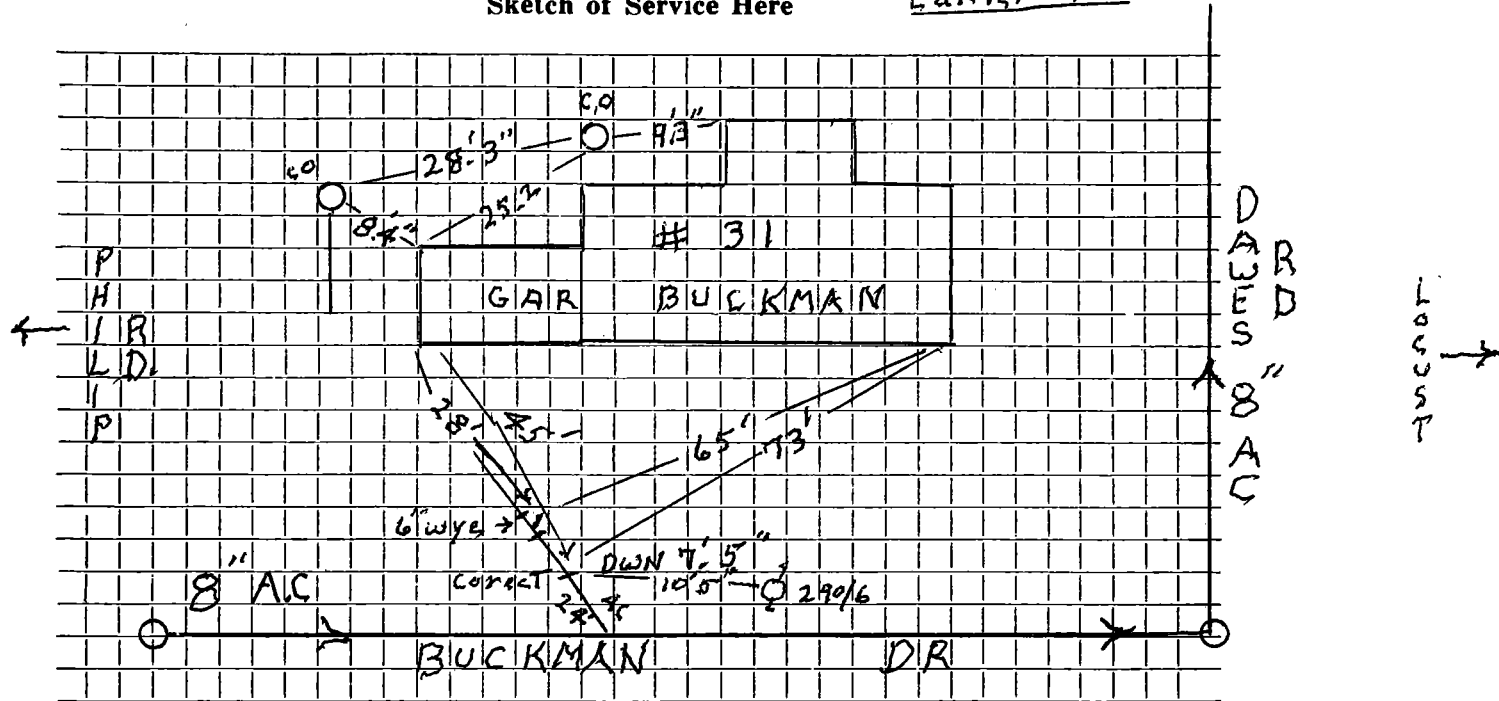

Connection made in Street. Work completed 01/2012 A. V. LEX.

Remarks: Left 6" wye for future use. DWN 6.5"

.....
.....